

26
SECTION

18
TOWN

05
RANGE

ADAMS COUNTY

COUNTY CORNER NO: 110

ROMPORTOL ID: 41805260020

PUBLIC LAND SURVEY MONUMENT RECORD


TYPE OF MONUMENT: HARRISON (BROKEN-TOP)
ADAMS COUNTY COORDINATES, NAD 83 (2007)

N. 229397.691

E. 517805.856

ELEVATION- DATUM

FIELD WORK DATE: 11/19/2018

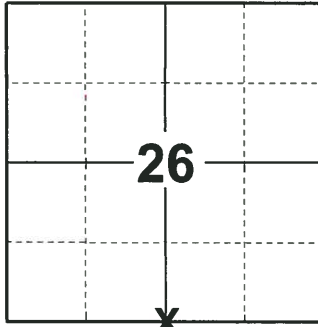

LOCATION

(INDICATE CORNER BY "X")

BASIS FOR MONUMENT LOCATION

1975 - PLS 922 USED THE CENTERLINE OF CZECH DRIVE AND THE FENCE LINE TO THE SOUTH. THIS LOCATION FIT AN E.D.M. TRAVERSE OF SECTION 35 GOOD.

2018 - PLS 2675 FOUND A HARRISON MONUMENT WITH A BROKEN-TOP 18" BELOW THE ROAD SURFACE. FOUND NO EVIDENCE OF ANY OF THE EXISTING TIES OR WITNESSES. ACCEPTED THE HARRISON MONUMENT WITH A BROKEN-TOP AS THE BEST EVIDENCE OF THE CORNER LOCATION. SET 4 NEW TIES AND MEASURED TO THE TIES.

SEAL:



DATA SHOWN HERE ON THIS TIE SHEET IS CORRECT AND COMPLETE TO THE BEST OF MY KNOWLEDGE AND BELIEF.



PROFESSIONAL LAND SURVEYOR

DATE 12/4/2018

- TIE SKETCH

NOTE: THE CORNER FALLS 2± SOUTH OF THE CENTERLINE OF CZECH AVE.

FIELD

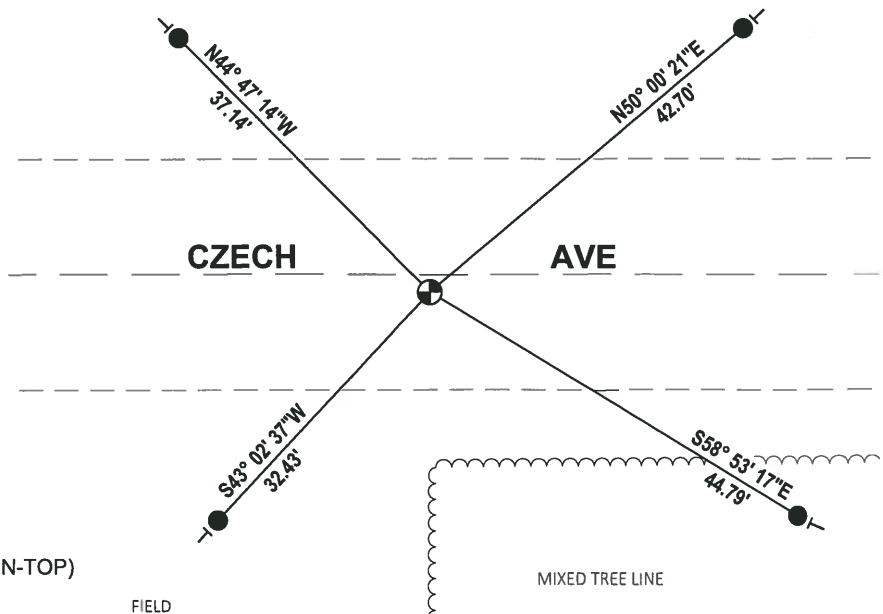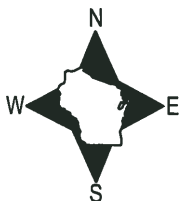

- SET 3/4" x 18" IRON REBAR, 1.50#/FT
- ⊕ FOUND HARRISON MONUMENT (BROKEN-TOP)
- VINYL "T" POST

FIELD

MIXED TREE LINE

ADAMS COUNTY

Survey Monument Record

TYPE OF MONUMENT: HARRISON MONUMENT

STATE PLANE COORDINATES: N _____

E _____

ELEVATION — M.S.L. DATUM: _____

THETA ANGLE: _____


FIELD BOOK: _____ PAGE _____

CORNER NO. 610

SECTION 35


TOWN 18

RANGE 5

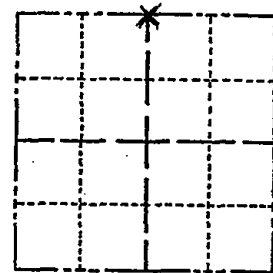

LOCATION
(Indicated by 'X')

SEAL:

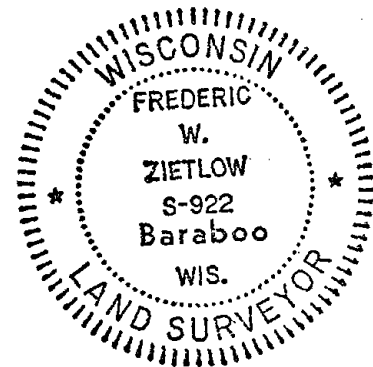

BASIS FOR MONUMENT LOCATION

(Use reverse side if necessary)

Show info such as: History of corner, with reference to Vol. and pg, dates, surveyor; exact description of monument replaced; if location computed, by taped or EDM traverse; landowner remarks, etc.

Used centerline of Czech Drive and fence line to south. Fit E.D.M. traverse of Section 35 good.

OK 7-23-83 BS
3-1-83 GR-SS OK

8-18-92 BS 1-GONE; 1-NEW MON. OK.

1-GONE, 2-NEW, MON. OK, 2-3-99-JG

RETIED 1-29-03, SEE REVERSE SIDE, MON. OK-JG

CERTIFIED CORRECT:



Frederic W. Zietlow

Registered Land Surveyor

DATE: JAN. 29, 1975

TIE SKETCH ALL OK, 12-11-07-JG-JS



(Show at least four ties)

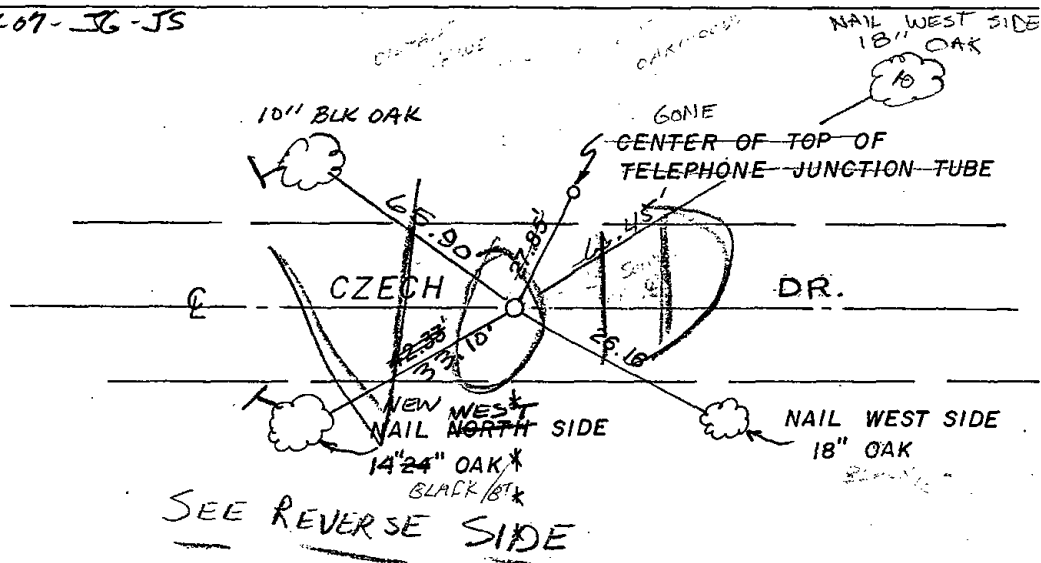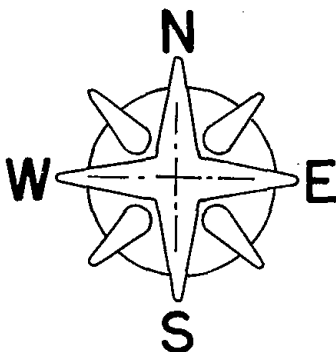

SEE REVERSE SIDE

(OVER)

FIELD
(NOTHING AVAILABLE)

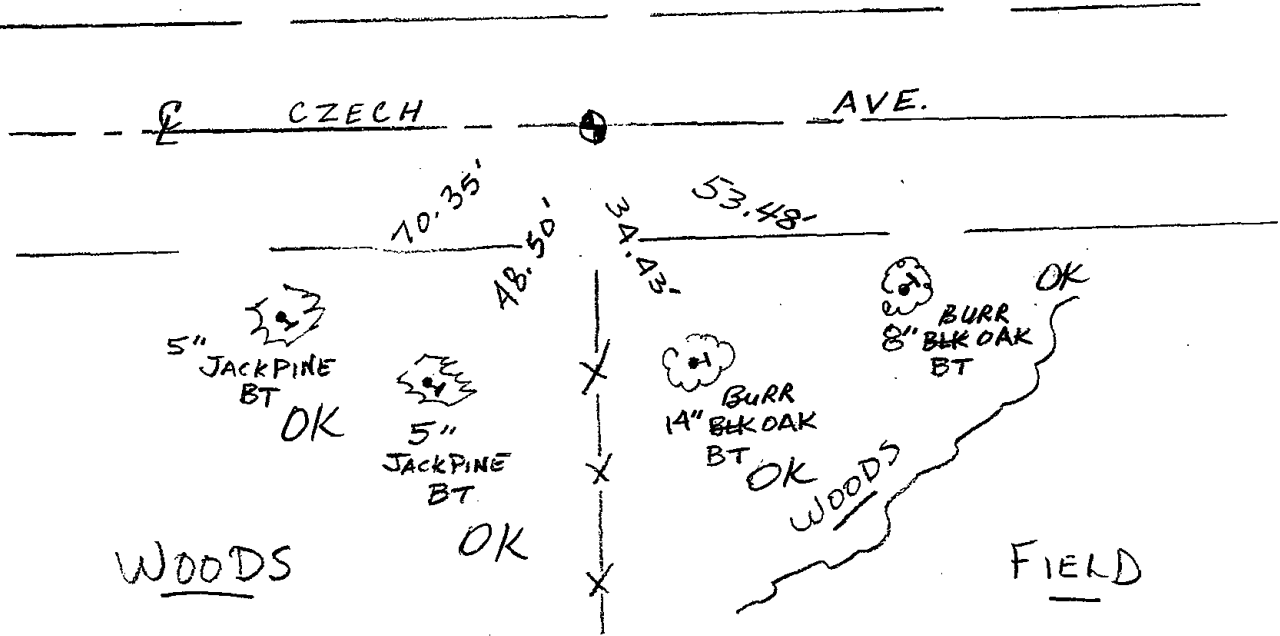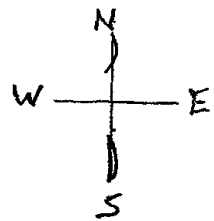

TOP BROKEN OFF HARRISON / 10" DEEP
LEFT HARRISON IN PLACE 5-13-04 JG-DA