

35  
SECTION

18  
TOWN

05  
RANGE

# ADAMS COUNTY

COUNTY CORNER NO: 119

ROMPORTOL ID: 41805352000

## PUBLIC LAND SURVEY MONUMENT RECORD

TYPE OF MONUMENT: HARRISON (BROKEN-TOP)  
ADAMS COUNTY COORDINATES, NAD 83 (2007)

N. 226778.712

E. 520429.128


ELEVATION-      DATUM     

FIELD WORK DATE: 11/21/2018

### BASIS FOR MONUMENT LOCATION

1973 - PLS 878 EXCAVATED AREA WITH A BACKHOE AND FOUND NO EVIDENCE OF THE CORNER. CALCULATED THE CORNER LOCATION ON LINE AND EQUIDISTANT BETWEEN SECTION CORNERS. SET A HARRISON MONUMENT.

2018 - PLS 2675 FOUND A HARRISON MONUMENT WITH A BROKEN-TOP 8" BELOW THE ROAD SURFACE. FOUND NO EVIDENCE OF ANY OF THE EXISTING TIES OR WITNESSES. AFTER REVIEW THE CORNER FALLS NEAR EQUIDISTANT AND ON LINE BETWEEN SECTION CORNERS. ACCEPTED THE HARRISON MONUMENT WITH A BROKEN-TOP AS THE BEST EVIDENCE OF THE CORNER LOCATION. SET 4 NEW TIES AND MEASURED TO THE TIES.

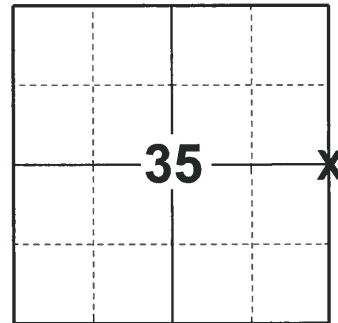

### LOCATION

(INDICATE CORNER BY "X")

SEAL:





DATA SHOWN HERE ON THIS TIE SHEET IS CORRECT AND COMPLETE TO THE BEST OF MY KNOWLEDGE AND BELIEF.

PROFESSIONAL LAND SURVEYOR

DATE 1-18-19

### - TIE SKETCH

NOTE: THE CORNER FALLS 4'± EAST OF THE CENTERLINE OF CTH N AND 275'± NORTH OF THE CENTERLINE OF CZECH DR.

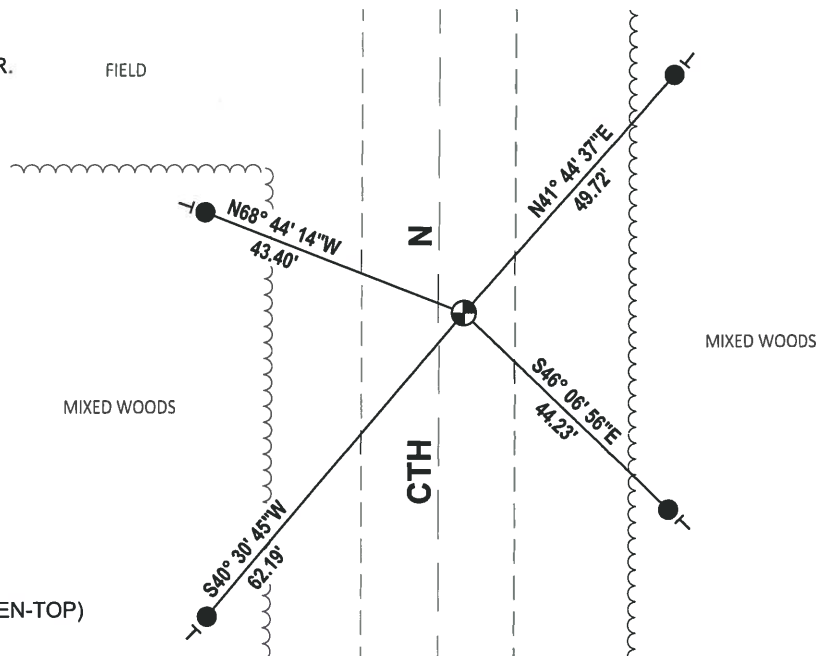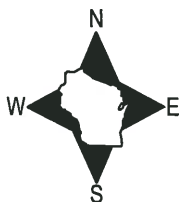

- SET 3/4" x 18" IRON REBAR, 1.50#/FT
- ⊕ FOUND HARRISON MONUMENT (BROKEN-TOP)
- VINYL "T" POST

# ADAMS COUNTY

## Survey Monument Record

CORNER NO. 320

SECTION 35

TOWN 18

RANGE 5

TYPE OF MONUMENT: 30" HARRISON


STATE PLANE COORDINATES: N \_\_\_\_\_

E \_\_\_\_\_

ELEVATION — M.S.L. DATUM: \_\_\_\_\_

THETA ANGLE: \_\_\_\_\_

FIELD BOOK: 108 PAGE 107

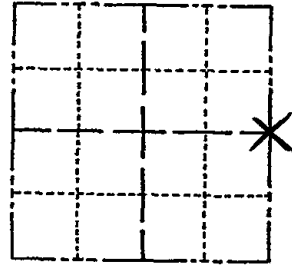

LOCATION  
(Indicated by 'X')

SEAL:



### BASIS FOR MONUMENT LOCATION

(Use reverse side if necessary)

Show info such as: History of corner, with reference to Vol. and pg, dates, surveyor; exact description of monument replaced; if location computed, by taped or EDM traverse; landowner remarks, etc.

Excavated area with backhoe.  
 Found no evidence of corner.  
 Point set on line equidistant  
 between section corners.

3-2-83 GR-SS 2 NEW TIES

8-18-92 BS MON. O.K.

1-GONE, 3-NEW TIES, TOP BROKEN OFF MON. 2-2-98 -JG

1-GONE- 4-LEFT, 1-30-03-JG

CERTIFIED CORRECT:

*Anthony B. Kiedrowski*

Registered Land Surveyor

DATE: 7/10/73

### TIE SKETCH

(Show at least four ties)

S. EDGE  
 STEEL R/W  
 POST

FIELD  
 CORNER IS  
 0.3' SO. OF  
 LINE BTWN  
 POSTS

