

PUBLIC LAND SURVEY MONUMENT RECORD

TYPE OF MONUMENT: 1" IRON ROD
 ADAMS COUNTY COORDINATES, NAD 83 (2007)

N. 224103.035

E. 501938.459


ELEVATION- _____ DATUM _____

FIELD WORK DATE: 12/19/2017

BASIS FOR MONUMENT LOCATION

1979 - PLS 1478 NO RECORD OF RESURVEYS. EXCAVATED WITH A BACKHOE AND FOUND NOTHING. CORNER WAS CALCULATED ON A LINE AND EQUIDISTANT BETWEEN SECTION CORNERS AFTER FINDING THE STONE MARKING THE SW CORNER OF THE SECTION. SET A HARRISON MONUMENT AT THE CORNER LOCATION AND TIED OUT.


2017 - PLS 2994 FOUND A 1" IRON ROD 2" BELOW THE GROUND SURFACE, 1 TIE AND 1 WITNESS TREE. THE MONUMENT AGREES WITH THE EXISTING TIE AND WITNESS TREE. ACCEPTED THE 1" IRON ROD AS THE CORNER LOCATION. SET 3 NEW TIES AND MEASURED TO THE TIES AND WITNESS TREE.

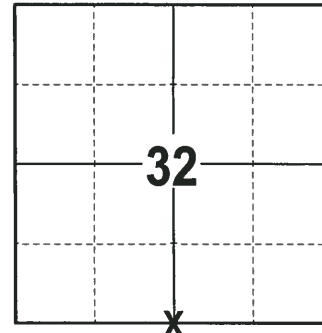

LOCATION

(INDICATE CORNER BY "X")

SEAL:

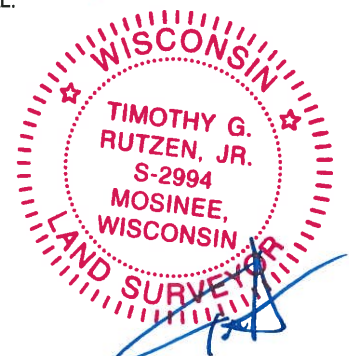

DATA SHOWN HERE ON THIS TIE SHEET IS CORRECT AND COMPLETE TO THE BEST OF MY KNOWLEDGE AND BELIEF.



PROFESSIONAL LAND SURVEYOR

DATE 1-4-18

- TIE SKETCH

NOTE 1: THE CORNER FALLS 14± NORTH OF THE CENTERLINE OF DAKOTA AVE.

NOTE 2: FOUND CP#7 A 1" O.D. IRON PIPE S01°33'02"W 15.85'.

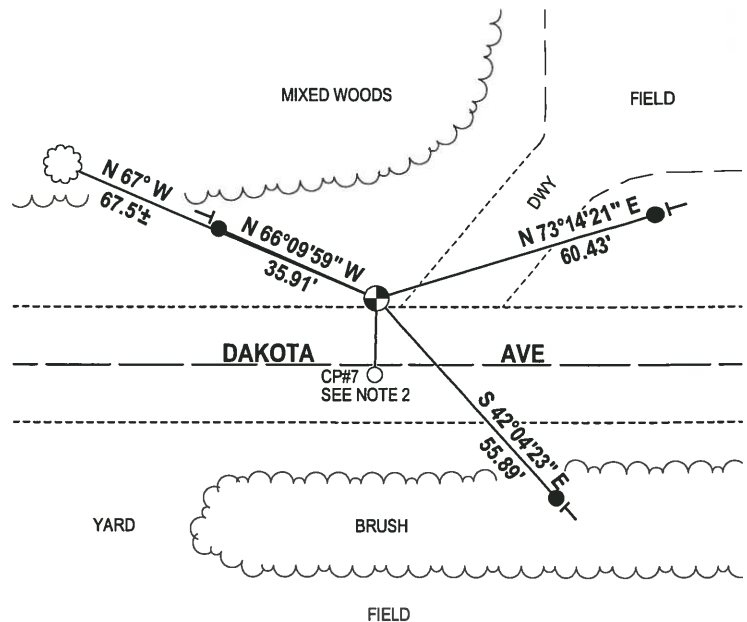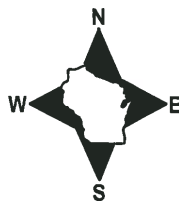


- 3/4" x 18" IRON REBAR SET, 1.50#/FT
- 1" O.D. IRON PIPE FOUND
- ⊕ 1" IRON ROD FOUND
- └ VINYL "T" POST
- ☁ WITNESS TREE FOUND

Government Land Corner Certificate

Adams County
 TYPE OF MONUMENT: Harrison STD
 STATE PLANE COORDINATES: N _____
 E _____
 ELEVATION — M.S.L. DATUM: _____
 THETA ANGLE: _____
 FIELD BOOK: 64 PAGE 138
 DRAWN BY: ABK

CORNER NO. 124
124
 SECTION 32
 TOWN 18
 RANGE 5

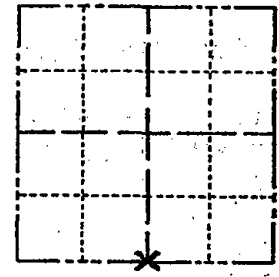

LOCATION
 (Indicated by 'X')


BASIS FOR MONUMENT LOCATION

Show info such as: History of corner, with reference to Vol. and pg., dates, surveyor; exact description of monument replaced; if location computed, by taped or EDM traverse; landowner remarks, etc. (Use reverse side if necessary)

No record of resurveys. Excavated with backhoe, found nothing. Corner set on line and equidistant between section corners after finding the stone marking SW corner of the section.



SEAL:

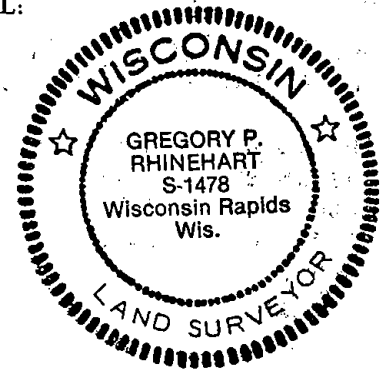


DATA SHOWN HERE ON
 CERTIFIED CORRECT:

Anthony B. Kiedrowski
 Registered Land Surveyor

DATE: 5/1/79

TIE SKETCH

Show at least four ties, also fence lines, roads, topo, size and type of witness trees' and if off road - best way to arrive at corner.

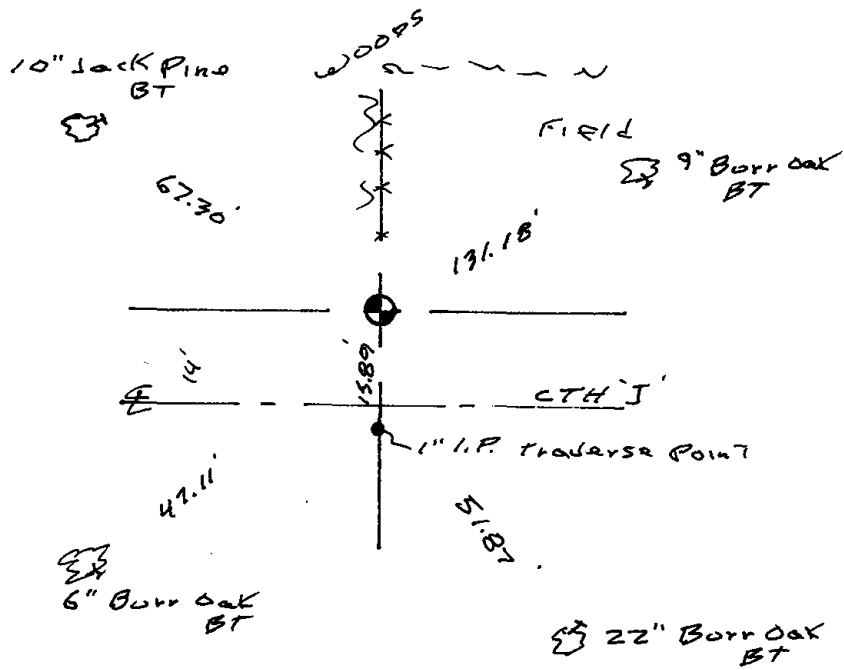

MAINTENANCE RECORD

Date	Init.	Remarks
3-2-83	GR-SS	OK
2-2-93	SS-SS	OK
2-5-98	GR-EG	OK
1-30-03	JG	OK
12-11-07	J&JS	OK