31 SECTION

OB ADAMS COUNTY

COUNTY CORNER NO: 122

ROMPORTOL ID: 41906310020


PUBLIC LAND SURVEY MONUMENT RECORD

HARRISON TYPE OF MONUMENT: ADAMS COUNTY COORDINATES, NAD 83 (2007) N. **255847.629** E. 528243.338 ELEVATION-DATUM FIELD WORK DATE: 01/23/2018


BASIS FOR MONUMENT LOCATION

2013 - PLS 1478 RE-DRAFTED PRIOR TIE SHEET BY ANTHONY B. KIEDROWSKI FROM 1978. KIEDROWSKI SET THE CORNER LOCATION ON A LINE AND PROPORTIONAL TO THE ORIGINAL NOTES BETWEEN ADJACENT SECTION CORNERS AND TIE OUT.

2018 - PLS 2994 FOUND A HARRISON MONUMENT 2" ABOVE THE GROUND SURFACE AND 3 WITNESSES. THE MONUMENT AGREES WITH THE EXISTING WITNESSES. ACCEPTED THE HARRISON MONUMENT AS THE CORNER LOCATION. SET 4 NEW TIES AND MEASURED TO THE TIES AND WITNESSES.

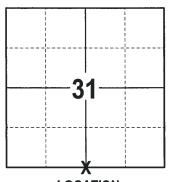

LOCATION (INDICATE CORNER BY "X")

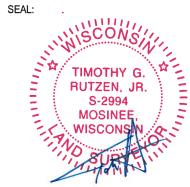

DATA SHOWN HERE ON THIS TIE SHEET IS CORRECT AND COMPLETE TO THE BEST OF MY KNOWLEDGE AND BELIEF.

PROFESSIONAL LAND SURVEYOR


DATE

- TIE SKETCH

NOTE: THE CORNER FALLS 105'± NORTH OF THE CENTERLINE OF THE TRAIL.



 3/4" x 18" IRON REBAR SET, 1.50#/FT WITNESS 4" CORNER POST W/DND SIGN FOUND HARRISON FOUND VINYL "T" POST WITNESS TREE FOUND

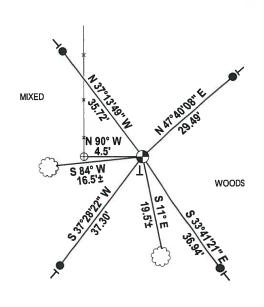

U.S PUBLIC LAND SURVEY MONUMENT RECORD CORNER NO. 2 SECTION 6 ADAMS COUNTY, WISCONSIN TOWN 18N RANGE 6E TYPE OF MONUMENT: HARRISON MONUMENT STATE PLANE COORDINATES: N: NOT APPLICABLE E: NOT APPLICABLE ELEVATION _ MSL DATUM: NOT APPLICABLE THETA ANGLE: NOT APPLICABLE FIELD BOOK: 57, PAGE 62 DRAWN BY: ERIC SCHOOT LOCATION BASIS FOR MONUMENT LOCATION Show info such as: History of corner, with reference to Vol. and pg., dates, surveyor; exact description of monument replaced if location computed, by taped or EDM traverse, landowner remarks, etc. Set on line and proportional to the original notes between adjacent section corners. RHINEHART S-1478 -Anthony B. Kiedrowski, 6-6-78 FRIENDSHIP DATA SHOWN HEREON CERTIFIED CORRECT: REGISTERED LAND SURVEYOR THIS IS A COMPILATION AND REDRAFT OF PREVIOUS MONUMENT RECORDS. DATE: 9 JULY, 2013 BASIS FOR MONUMENT LOCATION IS FROM ORIGINAL REMONUMENTATION. TIE SKETCH: No Scale 4" Cor. Post DND Sign Mag Nail 4.55' 6" Jack Plne MAINTENANCE RECORD DATE INIT. | REMARKS 10" Black Oak/BT Twin 10" Black Oak/BT