FIELD WORK DATE:

OB ADAMS COUNTY

COUNTY CORNER NO: 124

ROMPORTOL ID: 41906320020

PUBLIC LAND SURVEY MONUMENT RECORD


5" CONCRETE MONUMENT TYPE OF MONUMENT: ADAMS COUNTY COORDINATES, NAD 83 (2007) N. **255925.906** E. 533516.181 ELEVATION-DATUM

01/23/2018


BASIS FOR MONUMENT LOCATION

1974 - PLS 1103 FOUND 5-INCH DIAMETER CONCRETE MONUMENT. TRAVERSED SECTION 5 AND VERIFIED LOCATION WITH THE SOUTH QUARTER CORNER AND THE CENTER OF THE SECTION AND TIED OUT.

2018 - PLS 2994 FOUND A 5" CONCRETE MONUMENT 4" ABOVE THE GROUND SURFACE AND 2 WITNESS TREES. THE MONUMENT AGREES WITH THE EXISTING WITNESS TREES. ACCEPTED THE 5" CONCRETE MONUMENT AS THE CORNER LOCATION. SET 4 NEW TIES AND MEASURED TO THE TIES AND WITNESS TREES.

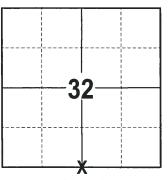

LOCATION (INDICATE CORNER BY "X")

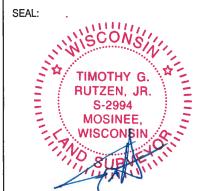


DATA SHOWN HERE ON THIS TIE SHEET IS CORRECT AND COMPLETE TO THE BEST OF MY KNOWLEDGE AND BELIEF.

PROFESSIONAL LAND SURVEYOR


DATE

- TIE SKETCH

NOTE: THE CORNER FALLS 6'± SOUTH OF THE CENTERLINE OF THE TRAIL.

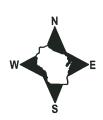

FIELD

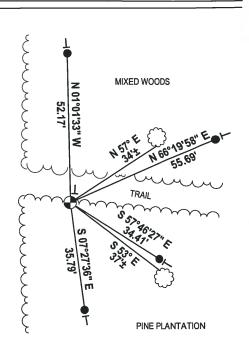

3/4" x 18" IRON REBAR SET, 1.50#/FT 5" CONCRETE MONUMENT FOUND VINYL "T" POST WITNESS TREE FOUND

ADAMS COUNTY CORNER NO. _ **SECTION** Survey Monument Record TOWN TYPE OF MONUMENT: 5-inch Diameter Concrete Monument RANGE STATE PLANE COORDINATES: N_ \mathbf{E}_{-} ELEVATION - M.S.L. DATUM: _ THETA ANGLE: _ FIELD BOOK: PAGE 2 BASIS FOR MONUMENT LOCATION (Use reverse side if necessary) Show info such as: History of corner, with reference to Vol. and pg, dates, surveyor; exact description of monument replaced; if location computed, by taped or EDM traverse; landowner SEAL: remarks, etc. Found 5-inch diameterconcrete monument and traversed Section 5. Checked with South Quarter corner and center of section. 11-30-78 RN-DA 3-8-83 GR-55 O.K. 8-11-92 56-B5 CERTIFIED CORRECT: ALL DK, 1-14-98-JG 3-60NE, 3-NEW, MON. OK, 11-15-07- JG-IS DATE: April 24 TIE SKETCH DEAD 07

