SECTION

TOWN

# ADAMS COUNTY

COUNTY CORNER NO: 133

ROMPORTOL ID: 41906360000


## PUBLIC LAND SURVEY MONUMENT RECORD

TYPE OF MONUMENT:	HARRISON (BROKEN-TOP)
ADAMS COUNTY COORDINATES, NAD 83 (2007)	
N. <b>255976.901</b>	
E. <u>557196.451</u>	
ELEVATION DAT	UM
FIELD WORK DATE: 01/12/20	18


#### BASIS FOR MONUMENT LOCATION

1976 - PLS 1103 RAN EDM/TRANSIT TRAVERSE AROUND SECTIONS 1, 12 AND PORTIONS OF ADJOINING SECTIONS TO DETERMINE THE SEARCH AREAS FOR INVESTIGATION. EXCAVATION WITH A BACKHOE YIELDED NO EVIDENCE OF THE ORIGINAL CORNER OR ANY REMONUMENTATION. AFTER A THOROUGH ANALYSIS OF ALL THE FIELD EVIDENCE OCCUPATION AND ORIGINAL NOTES, THIS CORNER WAS RELOCATED ON THE CENTERLINE OF CHICAGO AVENUE AND THE OPPOSITE FENCES NORTH AND SOUTH. SET A HARRISON MONUMENT AT THE CORNER LOCATION AND TIED OUT.

2018 - PLS 2994 FOUND A HARRISON MONUMENT WITH A BROKEN-TOP 6" BELOW THE ROAD SURFACE, 2 TIES AND 2 WITNESS TREES. THE MONUMENT AGREES WITH THE EXISTING TIES AND WITNESS TREES. ACCEPTED THE HARRISON MONUMENT WITH A BROKEN-TOP AS THE CORNER LOCATION. SET 4 NEW TIES AND MEASURED TO THE TIES AND WITNESS TREES.

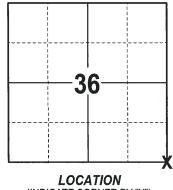

(INDICATE CORNER BY "X")

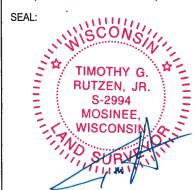

DATA SHOWN HERE ON THIS TIE SHEET IS CORRECT AND COMPLETE TO THE BEST OF MY KNOWLEDGE AND BELIEF.

PROFESSIONAL LAND SURVEYOR

DATE

#### - TIE SKETCH


NOTE 1:THE 1-1/2" O.D. IRON PIPE IS S 00°20'37" W, 32.86' FROM THE CORNER LOCATION.

NOTE 2: THE WITNESS TREE IS S 03° W, 25.5' FROM THE CORNER LOCATION.

NOTE 3: THE CORNER FALLS 0.5'± NORTH OF THE CENTERLINE OF CHICAGO AVE.



 3/4" x 18" IRON REBAR SET, 1.50#/FT ○ 1-1/2" O.D. IRON PIPE FOUND ⊕ 1" O.D. IRON PIPE FOUND 🕀 HARRISON (BROKEN-TOP) FOUND → VINYL "T" POST WITNESS TREE FOUND

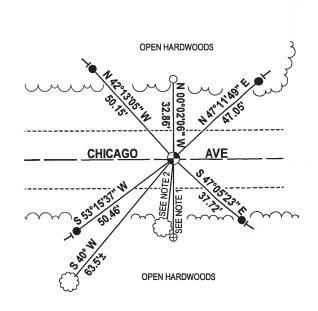

### CORNER NO. -ADAMS COUNTY SECTION Survey Monument Record TOWN TYPE OF MONUMENT: Harrison RANGE STATE PLANE COORDINATES: N ELEVATION — M.S.L. DATUM: THETA ANGLE: . FIELD BOOK: **PAGE** BASIS FOR MONUMENT LOCATION (Use reverse side if necessary) Show info such as: History of corner, with reference to Vol. and pg, dates, surveyor; exact description of monument replaced; if location computed, by taped or EDM traverse; landowner LOCATION (Indicated by 'X') SEAL: remarks, etc. Ran EDM/transit traverse around Sections 1 and 12, and portions of the adjoining sections to determine the search areas for investigation. DALE C. Excavation with backhoe yielded no evidence HAGEN of the original corner or and remonumentation. S-1103 Wisconsin Rapids. After a thorough analysis of all the field Wis. evidence, occupation and original notes, this corner was relocated on the centerline of Chicago Avenue and opposite fences North and South. Monument set 6-16-76. CERTIFIED CORRECT: 22-49 OK 11-22-78 6R-55 OK 3-4-83 1-NEW TIE MON OK. JG ALL OK, 2-23-98,-JG DATE: 11-12-02 OK. 12-20-07-NOTE: 8" Jack Pine/ Ties in trees to 7'5743 10"8lack nail and disc in blaze.

REVISED 1974