

04 SECTION 18 TOWN 06 RANGE

ADAMS COUNTY

COUNTY CORNER NO: 17
ROMPORTOL ID: 41806042000

PUBLIC LAND SURVEY MONUMENT RECORD

TYPE OF MONUMENT: HARRISON
ADAMS COUNTY COORDINATES, NAD 83 (2007)

N. 253263.033

E. 541376.920


ELEVATION- _____ DATUM _____

FIELD WORK DATE: 05/29/2019

BASIS FOR MONUMENT LOCATION

1977 - PLS 878 SET HARRISON PROPORTIONATE AND ON LINE BETWEEN ADJACENT SECTION CORNERS. EXCAVATED AREA WITH BACKHOE. FOUND NOTHING. NO RESURVEYS OF RECORD.

2019 - PLS 2675 FOUND A HARRISON MONUMENT 2" BELOW THE ROAD SURFACE AND 2 WITNESSES. THE MONUMENT AGREES WITH THE EXISTING WITNESSES. ACCEPTED THE HARRISON MONUMENT AS THE CORNER LOCATION. SET 4 NEW TIES. MEASURED TO THE TIES AND WITNESSES.

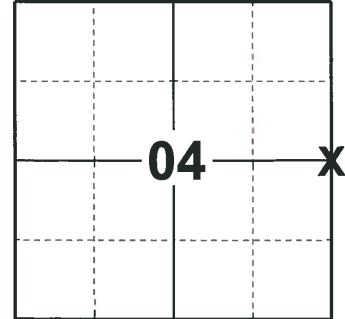

LOCATION

(INDICATE CORNER BY "X")

SEAL:





DATA SHOWN HERE ON THIS TIE SHEET IS CORRECT AND COMPLETE TO THE BEST OF MY KNOWLEDGE AND BELIEF.

PROFESSIONAL LAND SURVEYOR

DATE 8/2/19

TIE SKETCH

NOTE: THE CORNER FALLS ON THE CENTERLINE OF 10TH AVE.

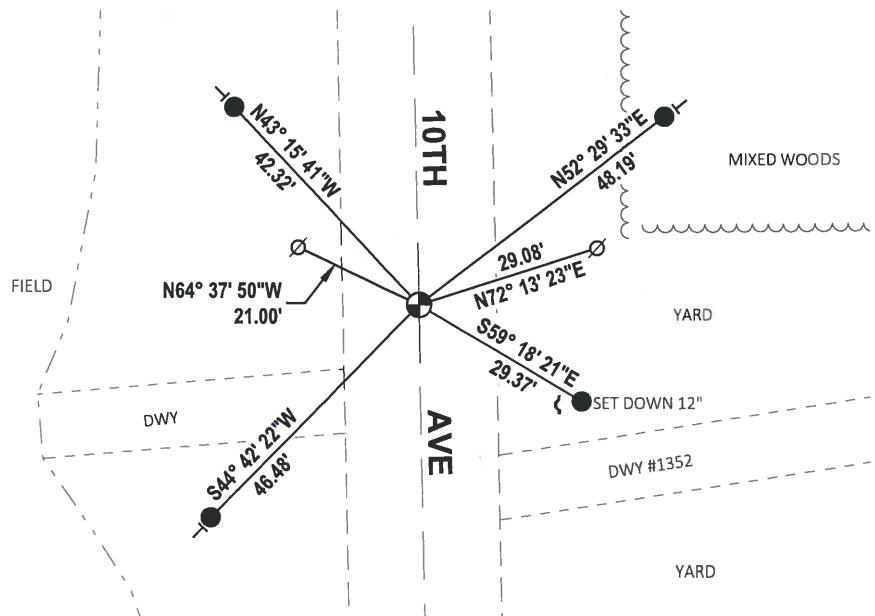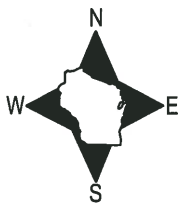


- SET 3/4" x 18" IRON REBAR, 1.50#/FT
- ⊕ FOUND HARRISON MONUMENT
- ⊘ WITNESS POWER POLE
- ✓ STEEL FENCE POST
- VINYL "T" POST

Government Land Corner Certificate

ADAMS County
 TYPE OF MONUMENT: HARRISON STD.
 STATE PLANE COORDINATES: N _____
 E _____
 ELEVATION — M.S.L. DATUM: _____
 THETA ANGLE: _____
 FIELD BOOK: 57 PAGE 46
 DRAWN BY: SCOTT SORENSEN

CORNER NO. 17
 SECTION 3
 TOWN 18
 RANGE 6

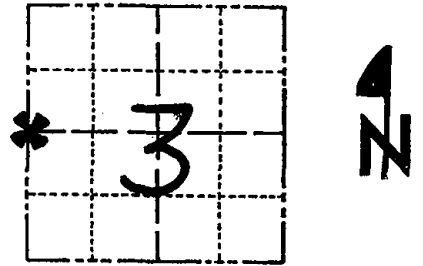

LOCATION
(Indicated by 'X')

BASIS FOR MONUMENT LOCATION

Show info such as: History of corner, with reference to Vol. and pg., dates, surveyor; exact description of monument replaced; if location computed, by taped or EDM traverse; landowner remarks, etc. (Use reverse side if necessary)

Set proportioate and on line between adjacent section corners.

Excavated area with backhoe. Found nothing.
 No resurveys of record.

OK 11-22-78 RN-SS

SEAL:




DATA SHOWN HERE ON
 CERTIFIED CORRECT:

Anthony B. Kiedrowski
 Registered Land Surveyor

DATE: 12/23/77

TIE SKETCH

Show at least four ties, also fence lines, roads, topo, size and type of witness trees' and if off road - best way to arrive at corner.

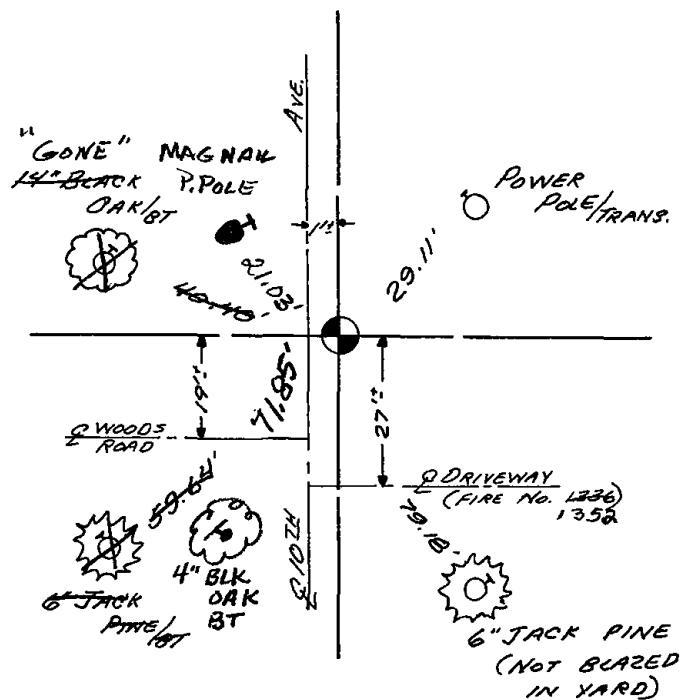

MAINTENANCE RECORD

Date	Init.	Remarks
3-4-83	SS	OK
2-11-88	GR-SS	OK
8-11-92	JG-BS	OK
2-24-98	JG	OK
12-17-02	JG	2-GONE, 2-NEW, MON. OK
12-20-07	JG-SS	OK