SECTION

TOWN

OB ADAMS COUNTY

COUNTY CORNER NO: 20

ROMPORTOL ID: 41806012000


PUBLIC LAND SURVEY MONUMENT RECORD

TYPE OF MONUMENT: **HARRISON** ADAMS COUNTY COORDINATES, NAD 83 (2007) N. **253501.212** E. 557179.818 ELEVATION-___ -- -- --DATUM 01/12/2018 FIELD WORK DATE:

BASIS FOR MONUMENT LOCATION

1976 - PLS 1103 RAN EDM/TRANSIT TRAVERSE AROUND SECTIONS 1, 12, AND PARTS OF ADJOINING SECTIONS TO DETERMINE SEARCH AREAS FOR INVESTIGATION. COULD FIND NO EVIDENCE OF THE ORIGINAL MONUMENTATION OR ANY SUBSEQUENT REMONUMENTATION. SET THE CORNER ON A LINE AND PROPORTIONATE TO THE ORIGINAL NOTES BETWEEN THE NORTHEAST AND SOUTHEAST CORNERS OF SECTION 1 AND TIED OUT.

2017 - PLS 2994 FOUND A HARRISON MONUMENT FLUSH WITH THE GROUND SURFACE, 1 TIE AND 3 WITNESS TREES. THE MONUMENT AGREES WITH THE EXISTING TIE AND WITNESS TREES. ACCEPTED THE HARRISON MONUMENT AS THE CORNER LOCATION, SET 3 NEW TIES AND MEASURED TO THE TIES AND WITNESS TREES.

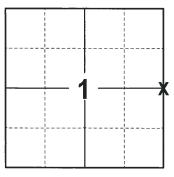

LOCATION (INDICATE CORNER BY "X")



DATA SHOWN HERE ON THIS TIE SHEET IS CORRECT AND COMPLETE TO THE BEST OF MY KNOWLEDGE AND BELIEF.

PROFESSIONAL LAND SURVEYOR

2-2-18


- TIE SKETCH



3/4" x 18" IRON REBAR SET, 1.50#/FT 1-1/4" O.D. IRON PIPE FOUND HARRISON FOUND ✓ STEEL FENCE POST

→ VINYL "T" POST

WITNESS TREE FOUND

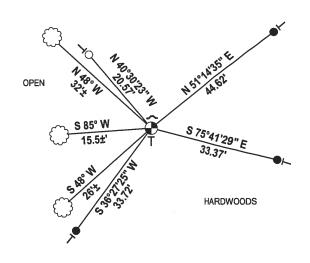

ADAMS COUNTY CORNER NO. -SECTION Survey Monument Record TYPE OF MONUMENT: 4" IronBar in Stump (Aspen) HARRISON TOWN STATE PLANE COORDINATES: N. **RANGE** ELEVATION — M.S.L. DATUM: THETA ANGLE: . 50 FIELD BOOK: ___ PAGE BASIS FOR MONUMENT LOCATION DALE C. HAGEN S-1103 Wisconsin Rapids, Wis. (Use reverse side if necessary) Show info such as: History of corner, with reference to Vol. and pg, dates, surveyor; exact description of monument replaced; if location computed, by taped or EDM traverse; landowner SEAL: remarks, etc. Ran EDM/transit traverse around Sections 1 and 12, and parts of adjoining sections to determine search areas for investigation. Could find no evidence of the original monumentation or any subsequent remonumentation. Set corner on line and proportionate to original notes between the Northeast and Southeast corners of Section 1. Set 6-16-76. CERTIFIED CORRECT: ALL TIES OK, NEW MONUMENT NEEDS Registered Land Surveyor TO BE SET 70 BE SET 2-25-98-JG 9-8-2008-FO. WARRISON - NEW 9-21-76 DATE: TIE SKETCH FO I TROW PIPE Oak, (Show at least four ties) NOTE: up I 15" IN45°W Ties in trees to nail and disc in blaze. NAIL 4 (HIGH) BLK DAK (NAIL 4' HIGH) MAPLE IN CLUSTER SHON FACES WEST 6"MARECO 2 545° W Note: set 1/2" Iron rod in 3' high Poplar stump 8"dia.

Stump scribed on North side E 1/4 1-18-6 June 16, 1976