# OF ADAMS COUNTY COUNTY CORNER NO: 31

ROMPORTOL ID: 41806020000

## PUBLIC LAND SURVEY MONUMENT RECORD

**HARRISON** TYPE OF MONUMENT:\_ ADAMS COUNTY COORDINATES, NAD 83 (2007) N. 250743.523

E. 551894.641

ELEVATION- - - DATUM


12/16/2019 FIELD WORK DATE:\_\_\_

#### BASIS FOR MONUMENT LOCATION


1976 - PLS 1103 RAN EDM/TRANSIT TRAVERSE AROUND SECTIONS 1 AND 12, AND PORTIONS OF ADJOINING SECTIONS TO DETERMINE SEARCH AREAS FOR INVESTIGATION. INVESTIGATION YIELDED NO EVIDENCE OF THE ORIGINAL CORNER OR ANY REMONUMENTATION. SET HARRISON BY DOUBLE PROPORTIONATE MEASURE (WI OF SEC 1, SW OF SEC 12, SE OF SEC 1 AND SI OF SEC 2) AFTER ANALYSIS OF EVIDENCE AND FINDING NO BETTER EVIDENCE.

2013 - PLS 1478 REDREW TIE SHEET.

2019 - PLS 2675 FOUND HARRISON 3" BELOW THE WATER SURFACE AND 2 WITNESS TREES. THE MONUMENT AGREES WITH THE WITNESS TREES. ACCEPTED THE HARRISON AS THE CORNER LOCATION. SET 4 NEW TIES AND MEASURED TO THE EXISTING WITNESS TREES.

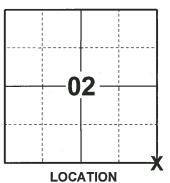

(INDICATE CORNER BY "X")

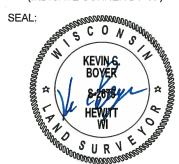

DATA SHOWN HERE ON THIS TIE SHEET IS CORRECT AND COMPLETE TO THE BEST OF MY KNOWLEDGE AND BELIEF.


PROFESSIONAL/LAND SURVEYOR

7070

#### -TIE SKETCH



- SET 3/4" x 18" IRON REBAR, 1.50#/FT
- FOUND HARRISON MONUMENT
- VINYL "T" POST
- WITNESS TREE

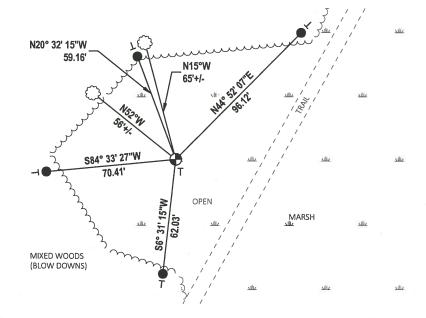

### ADAMS COUNTY SECTION Survey Monument Record TYPE OF MONUMENT: Harrison TOWN RANGE STATE PLANE COORDINATES: N ELEVATION — M.S.L. DATUM: . THETA ANGLE: . FIELD BOOK: . **PAGE** DALE C. HAGEN S-1103 Wisconsin Rapid Wis. BASIS FOR MONUMENT LOCATION (Use reverse side if necessary) Show info such as: History of corner, with reference to Vol. and pg, dates, surveyor; exact description of monument replaced; if location computed, by taped or EDM traverse; landowner SEAL: Ran EDM/transit traverse around Sections 1 and 12, and portions of adjoining sections to determine search areas for investigation. Investigation yielded no evidence of the original corner or any remonumentation. Set corner by double proportionate measure(W% of Sec 1, SW of Sec 12, SE of Sec 1 and S% of Sec 2) after analysis of evidence and finding no better evidence. Set 6-22-76. CERTIFIED CORRECT: 11-22-78 RK1-SS OK 4-19-83 6R-55 1 GONE AVALL. 1 NEW 1988-64-55 NOTHING Registered Land Surveyo DATE: 9-21-76 1-11-93 JG-55 1-GONE, 1-NEW, MON. OK. 2-25-98- JG TIE SKETCH 08-GPR 2 NEW DES OK 1-3-03 ML (Show at least four ties) NOTE: 8"Black Oak/gr Ties in trees to nail and disc in blaze. 7" J. PINE DUDSIGN (FACES EAST) (1988) 60NE 8" Black METAL T-Post 8" BIK OAK

REVISED 1974