OF RANGE ADAMS COUNTY COUNTY CORNER NO: 32

ROMPORTOL ID: 41806010020

PUBLIC LAND SURVEY MONUMENT RECORD


HARRISON TYPE OF MONUMENT: ADAMS COUNTY COORDINATES, NAD 83 (2007) N. **250802.335** E. 554528.036 ELEVATION- - - DATUM 12/11/2019 FIELD WORK DATE:_

BASIS FOR MONUMENT LOCATION


1976 - PLS 1103 RAN EDM/TRANSIT TRAVERSE AROUND SECTION 1 AND 12, AND PARTS OF ADJOINING SECTIONS TO DETERMINE SEARCH AREAS FOR INVESTIGATION. COULD FIND NO EVIDENCE OF THE ORIGINAL CORNER OR ANY REMONUMENTATION. SET HARRISON ON LINE AND PROPORTIONATE TO THE ORIGINAL NOTES BETWEEN THE SOUTHEAST AND SOUTHWEST CORNERS OF SECTION 1.

2013 - PLS 1478 REDREW TIE SHEET.

2019 - - PLS 2675 FOUND HARRISON AND 4 WITNESS TREES. THE MONUMENT AGREES WITH ALL 4 WITNESS TREES. ACCEPTED THE HARRISON AS THE CORNER LOCATION. SET 4 NEW TIES AND MEASURED TO THE EXISTING WITNESS TREES.

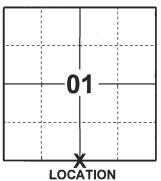

(INDICATE CORNER BY "X")

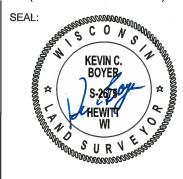


DATA SHOWN HERE ON THIS TIE SHEET IS CORRECT AND COMPLETE TO THE BEST OF MY KNOWLEDGE AND BELIEF.

PROFESSIONAL LAND SURVEYOR 2020

-TIE SKETCH



- SET 3/4" x 18" IRON REBAR, 1.50#/FT
- FOUND HARRISON MONUMENT
- VINYL "T" POST
- WITNESS TREE

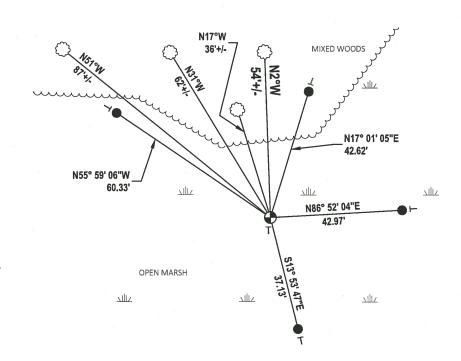


ADAMS COUNTY

Survey Monument Record

TYPE OF MONUMENT: _ Harrison STATE PLANE COORDINATES: N.

ELEVATION — M.S.L. DATUM: .

THETA ANGLE: . FIELD BOOK: _ PAGE

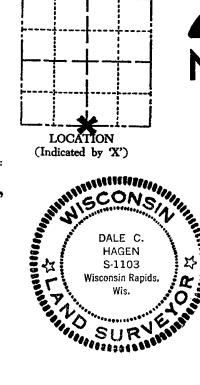

BASIS FOR MONUMENT LOCATION

(Use reverse side if necessary)

Show info such as: History of corner, with reference to Vol. and pg, dates, surveyor; exact description of monument replaced; if location computed, by taped or EDM traverse; landowner remarks, etc.

Ran EDM/transit traverse around Sections 1 and 12, and parts of adjoining sections to determine search areas for investigation.

Could find no evidence of the original corner or any remonumentation.

Set corner on line and proportionate to original notes between the Southeast and Southwest corners of Section 1.

Set 6-17-76.


PN-SS 11-22-78 OK 6R-55 4-19-83 1-11-93 JG-55 1 NEW OK 2-25-98- JG

CERTIFIED CORRECT:

SEAL:

Registered Land Surveyor

DATE: 9-21-76

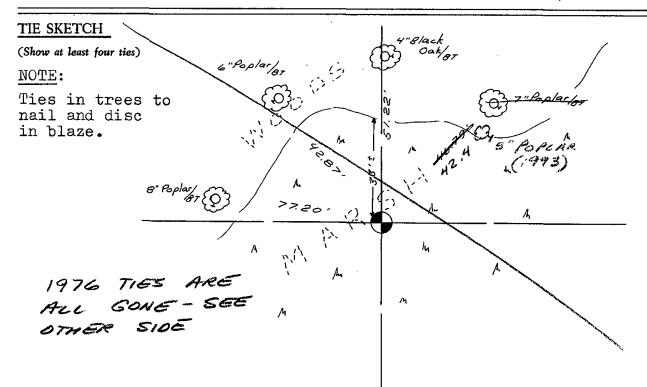

CORNER NO. _

SECTION 18 TOWN

RANGE

REVISED 1974

12" BLACK 8" BLACK OAK 152°4 86,> 12 1 HARRISON MONUMENT