# **D6** ADAMS COUNTY

COUNTY CORNER NO: 33

ROMPORTOL ID: 41806010000


## PUBLIC LAND SURVEY MONUMENT RECORD

**HARRISON** TYPE OF MONUMENT: ADAMS COUNTY COORDINATES, NAD 83 (2007) N. **250861.057** E. <u>557161.659</u> DATUM **ELEVATION-**01/12/2018 FIELD WORK DATE:

#### BASIS FOR MONUMENT LOCATION

2013 - PLS 1478 RE-DRAFTED PRIOR TIE SHEET BY DALE C. HAGEN FROM 1976. HAGEN RAN EDM/TRANSIT TRAVERSE AROUND SECTIONS 1, 12, AND PARTS OF ADJOINING SECTIONS TO DETERMINE SEARCH AREAS FOR INVESTIGATION. FOUND NO EVIDENCE OF THE ORIGINAL CORNER OR ANY REMONUMENTATION. SET THE CORNER BY SINGLE PROPORTIONATE MEASUREMENT BETWEEN THE NORTHEAST CORNER OF SECTION 1 AND THE SOUTHEAST CORNER OF SECTION 12, SETTING THE CORNER ON A LINE FROM THE NORTHEAST CORNER OF SECTION 1 EXTENDED THROUGH THE REMAINS OF THE OLD FENCE NEAR THE EAST QUARTER CORNER OF SECTION 1.

2017 - PLS 2994 FOUND A HARRISON MONUMENT 4" ABOVE THE GROUND SURFACE AND 2 WITNESS TREES, THE MONUMENT AGREES WITH THE EXISTING WITNESS TREES, ACCEPTED THE HARRISON MONUMENT AS THE CORNER LOCATION. SET 4 NEW TIES AND MEASURED TO THE TIES AND WITNESS TREES.

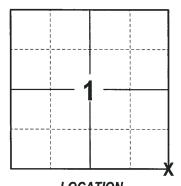

LOCATION (INDICATE CORNER BY "X")



DATA SHOWN HERE ON THIS TIE SHEET IS CORRECT AND COMPLETE TO THE BEST OF MY KNOWLEDGE AND BELIEF.


PROFESSIONAL LAND SURVEYOR

#### - TIE SKETCH

NOTE 1: WITNESS TREE IS LOCATED S 54° W. 4.5'±.

NOTE 2: THE CORNER FALLS 11'± WEST OF THE CENTERLINE OF THE TRAIL.



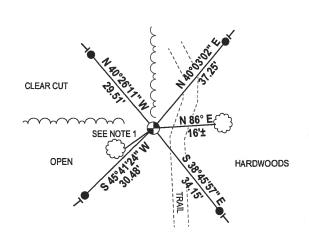

3/4" x 18" IRON REBAR SET, 1.50#/FT HARRISON FOUND VINYL "T" POST WITNESS TREE FOUND

### U.S PUBLIC LAND SURVEY MONUMENT RECORD CORNER NO. 33 ADAMS COUNTY, WISCONSIN SECTION 1 TOWN 18N RANGE 6E TYPE OF MONUMENT: HARRISON MONUMENT STATE PLANE COORDINATES: N: NOT APPLICABLE E: NOT APPLICABLE ELEVATION \_ MSL DATUM: NOT APPLICABLE

THETA ANGLE: NOT APPLICABLE FIELD BOOK: 37, PAGE 51 DRAWN BY: ERIC SCHOOT

# LOCATION

#### BASIS FOR MONUMENT LOCATION

Show info such as: History of corner, with reference to Vol. and pg., dates, surveyor; exact description of monument replaced if location computed, by taped or EDM traverse, landowner remarks, etc.

Ran EDM/transit traverse around Section 1 and 12, and parts of adjoining sections to determine search areas for investigation. Could find no evidence of the original corner or any remonumentation. Set corner by single proportionate measure between the Northeast corner of Section 1 and the Southeast corner of Section 12, setting corner on line from Northeast corner of Section 1 extended through remains of old fence near East Quarter corner of Section 1. Set 6-17-76. -Dale C. Hagen, 9-21-1976

THIS IS A COMPILATION AND REDRAFT OF PREVIOUS MONUMENT RECORDS. BASIS FOR MONUMENT LOCATION IS FROM ORIGINAL REMONUMENTATION.

SEAL RHINEHART S-1478 FRIENDSHIP DATA SHOWN HEREON CERTIFIED CORRECT: REGISTERED LAND SURVEYOR DATE: 30 JULY, 2013

