06 ADAMS COUNTY COUNTY CORNER NO: 35

ROMPORTOL ID: 41806072000

PUBLIC LAND SURVEY MONUMENT RECORD


HARRISON TYPE OF MONUMENT:_ ADAMS COUNTY COORDINATES, NAD 83 (2007) N. **247857.354** E. 530855.259 DATUM

FIELD WORK DATE: 12/17/2019


BASIS FOR MONUMENT LOCATION

1981 - PLS 1167 SEARCHED AREA FOR EVIDENCE OF ORIGINAL MONUMENT AND FOR REMONUMENTED CORNER. UNABLE TO LOCATED EITHER. SET E1/4 CORNER MIDWAY ON A STRAIGHT LINE BETWEEN ADJACENT SECTION CORNERS. RAN EDM TRAVERSE.

2019 - PLS 2675 FOUND HARRISON 12" BELOW THE GROUND AND 4 WITNESS TREES. THE MONUMENT AGREES WITH ALL 4 WITNESS TREES. ACCEPTED THE HARRISON AS THE CORNER LOCATION. SET 4 NEW TIES AND MEASURED TO THE EXISTING WITNESS TREES.

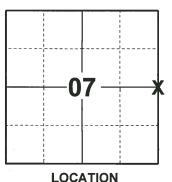

(INDICATE CORNER BY "X")

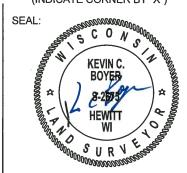

DATA SHOWN HERE ON THIS TIE SHEET IS CORRECT AND COMPLETE TO THE BEST OF MY KNOWLEDGE AND BELIEF.


PROFESSIONAL LAND SURVEYOR

-TIE SKETCH

NOTE 1: THE CORNER LANDS INSIDE OF WOODLINE 4'±. NOTE 2: TIE THAT LANDS IN FIELD IS 18" BELOW GROUND SURFACE.



- SET 3/4" x 18" IRON REBAR, 1.50#/FT
- FOUND HARRISON MONUMENT
- VINYL "T" POST
- WITNESS TREE
- ✓ STEEL FENCE POST

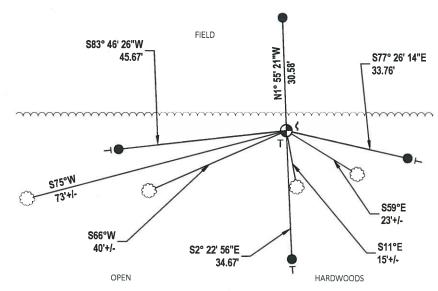

35 Government Land Corner Certificate CORNER NO. County SECTION TYPE OF MONUMENT: HARRISON TOWN STATE PLANE COORDINATES: RANGE ELEVATION — M.S.L. DATUM: THETA ANGLE: FIELD BOOK: **PAGE** DRAWN BY: BASIS FOR MONUMENT LOCATION Show info such as: History of corner, with reference to Vol. and pg., dates, surveyor; exact description of monument replaced; if location computed, by taped or EDM traverse; landowner remarks, etc. (Use reverse side if necessary) LOCATION (Indicated by 'X') SEAL: Searched area for evidence of original monument and for remonumented corner. We were unable to locate either. Set E% Cor. midway on a straight line between adjacent section corners. Ran EDM traverse. WAYNE BASLER 1167 WIS. RAPIDS DATA SHOWN HERE ON CERTIFIED CORRECT: Registered Land Surveyo DATE: TIE SKETCH Show at least four ties, also fence lines, roads, topo, size and type of witness trees' and if off road - best way to arrive at corner. METAL ENUT POST

Medisone)

MAINTENANCE RECORD

DATE	BY WHOM	REMARKS
3-8-83	GR - 55	o K
	JG - BS	I- NEW TIE, MON. OK
4-10-98	TG-55	2-GONE, 1-NEW, MON. DK
12-17-02	JG JG	2-GONE 1-NEW, MON. OK
11-27-07	56	OK'
	† · · · · · · · · · · · · · · · · · · ·	