18 TOWN

# 06 ADAMS COUNTY COUNTY CORNER NO: 39

ROMPORTOL ID: 41806112000


## PUBLIC LAND SURVEY MONUMENT RECORD

**HARRISON** TYPE OF MONUMENT:\_ ADAMS COUNTY COORDINATES, NAD 83 (2007) N. 248103.914 E. 551913.512 ELEVATION- - - DATUM FIELD WORK DATE:\_ 12/16/2019

#### BASIS FOR MONUMENT LOCATION


1977 - PLS 1103 RAN EDM/TRANSIT TRAVERSE AROUND SECTIONS 1 AND 12, AND PARTS OF ADJOINING SECTIONS TO DETERMINE SEARCH AREAS, INVESTIGATION YIELDED NO EVIDENCE OF THE ORIGINAL CORNER, AND REMONUMENTATION, OR ANY WITNESS TREES. RELOCATED CORNER BY SINGLE PROPORTIONATE MEASURE ON LINE BETWEEN ADJACENT SECTION CORNERS. SET HARRISON MONUMENT.

2019 - PLS 2675 FOUND HARRISON 2" ABOVE THE GROUND AND 2 WITNESS TREES. THE MONUMENT AGREES WITH BOTH WITNESS TREES. ACCEPTED THE HARRISON AS THE CORNER LOCATION. SET 4 NEW TIES AND MEASURED TO THE EXISTING WITNESS TREES.

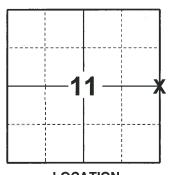

LOCATION

(INDICATE CORNER BY "X")

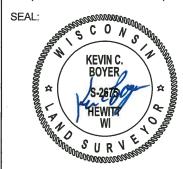

DATA SHOWN HERE ON THIS TIE SHEET IS CORRECT AND COMPLETE TO THE BEST OF MY KNOWLEDGE AND BELIEF.


PROFESSIONAL LAND SURVEYOR

7020

#### -TIE SKETCH



- SET 3/4" x 18" IRON REBAR, 1.50#/FT
- FOUND HARRISON MONUMENT
- STEEL FENCE POST
- VINYL "T" POST
- WITNESS TREE

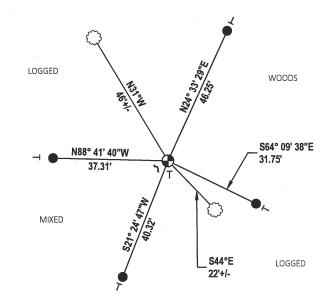

### ADAMS COUNTY CORNER NO. SECTION Survey Monument Record TOWN TYPE OF MONUMENT: HARRISON **RANGE** STATE PLANE COORDINATES: N. ELEVATION - M.S.L. DATUM: \_ THETA ANGLE: \_ FIELD BOOK: \_\_\_\_39 \_ PAGE \_\_ BASIS FOR MONUMENT LOCATION (Use reverse side if necessary) Show info such as: History of corner, with reference to Vol. and pg, dates, surveyor; exact description of monument replaced; if location computed, by taped or EDM traverse; landowner SEAL: Ran EDM/transit traverse around Sections 1 and 12, and parts of adjoining sections to deftemine search areas. Investigation yielded no evidence of the orignial corner, any remonumentation, or any witness trees. Relocated corner by single proportionate measure on line between adjacent section corners. Set Harrison Monument on 12-15-76. OK RN-DA 10-30-78 612-55 4.19.83 GR-SS 5-11-88 J6-55 1-11-93 TIE Registered Land Surveyor ALL OK 4-27-98 JJ5 DATE:

39

12

18

6

