

10 SECTION 18 TOWN 06 RANGE

ADAMS COUNTY

COUNTY CORNER NO: 48
 ROMPORTOL ID: 41806100020

PUBLIC LAND SURVEY MONUMENT RECORD


TYPE OF MONUMENT: HARRISON
 ADAMS COUNTY COORDINATES, NAD 83 (2007)

N. 245356.595

E. 544016.301

ELEVATION- - - - DATUM - - - -


FIELD WORK DATE: 06/03/2019

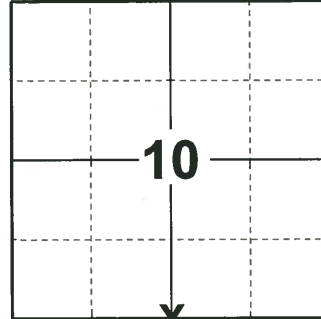

LOCATION

(INDICATE CORNER BY "X")

SEAL:

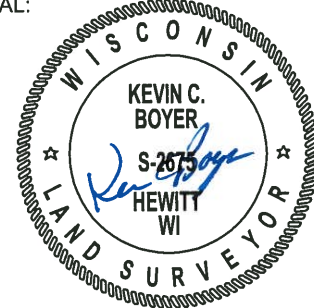

DATA SHOWN HERE ON THIS TIE SHEET IS CORRECT AND COMPLETE TO THE BEST OF MY KNOWLEDGE AND BELIEF.

PROFESSIONAL LAND SURVEYOR

DATE 8/2/19


BASIS FOR MONUMENT LOCATION

1978- PLS 878 HARRISON WAS SET PROPORTIONAL TO THE ORIGINAL NOTES AND ON LINE BETWEEN ADJACENT SECTION CORNERS.

2019 - PLS 2675 FOUND A HARRISON MONUMENT FLUSH WITH THE GROUND SURFACE AND 3 WITNESS TREES. THE MONUMENT AGREES WITH THE EXISTING WITNESS TREES. ACCEPTED THE HARRISON MONUMENT AS THE CORNER LOCATION. SET 4 NEW TIES. MEASURED TO THE TIES AND WITNESSES.

-TIE SKETCH-

NOTE: THE CORNER FALLS 37'± SOUTH OF THE CENTERLINE OF CREE AVE.

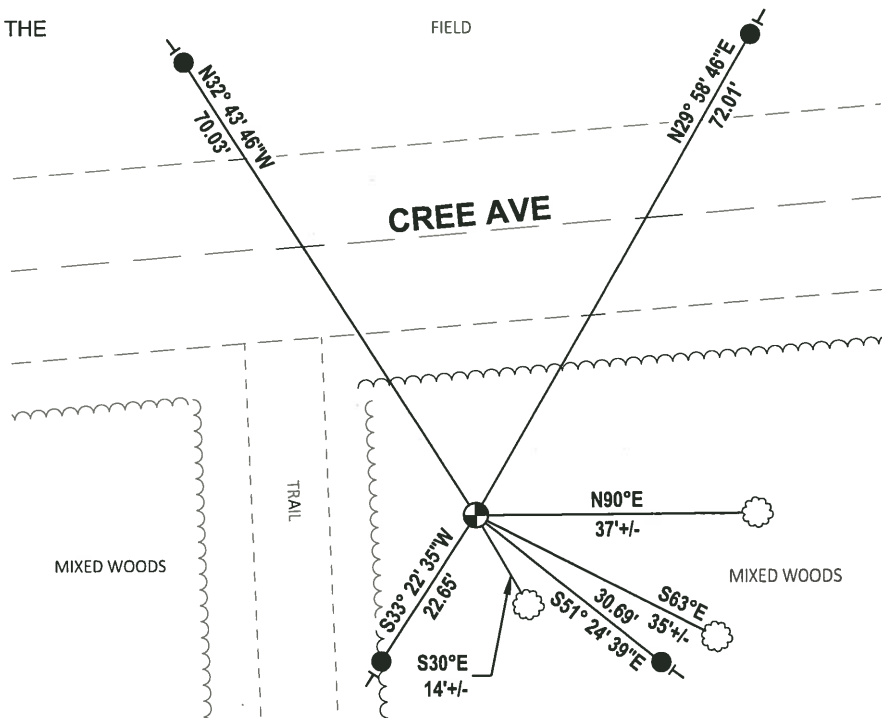


- SET 3/4" x 18" IRON REBAR, 1.50#/FT
- ⊕ FOUND HARRISON MONUMENT
- VINYL "T" POST
- ⊗ WITNESS TREE

Government Land Corner Certificate

ADAMS County
 TYPE OF MONUMENT: HARRISON
 STATE PLANE COORDINATES: N _____
 E _____
 ELEVATION — M.S.L. DATUM: _____
 THETA ANGLE: _____
 FIELD BOOK: 57 PAGE 19
 DRAWN BY: LANCE HARECK

CORNER NO. 48
 SECTION 10
 TOWN 18 N
 RANGE 6 E

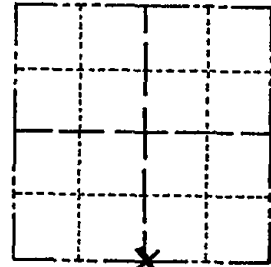


LOCATION
 (Indicated by 'X')

BASIS FOR MONUMENT LOCATION

Show info such as: History of corner, with reference to Vol. and pg., dates, surveyor; exact description of monument replaced; if location computed, by taped or EDM traverse; landowner remarks, etc. (Use reverse side if necessary)

This corner was set proportional to the original notes and on line between adjacent section corners.

SEAL:

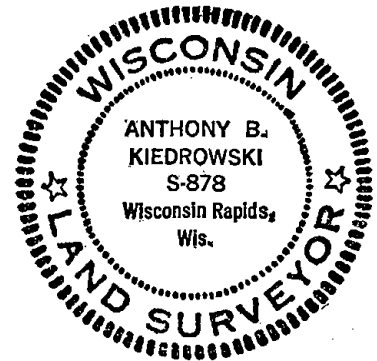


DATA SHOWN HERE ON
 CERTIFIED CORRECT:

Anthony B. Kiedrowski
 Registered Land Surveyor

DATE: 9/6/78

TIE SKETCH

Show at least four ties, also fence lines, roads, topo, size and type of witness trees' and if off road - best way to arrive at corner.

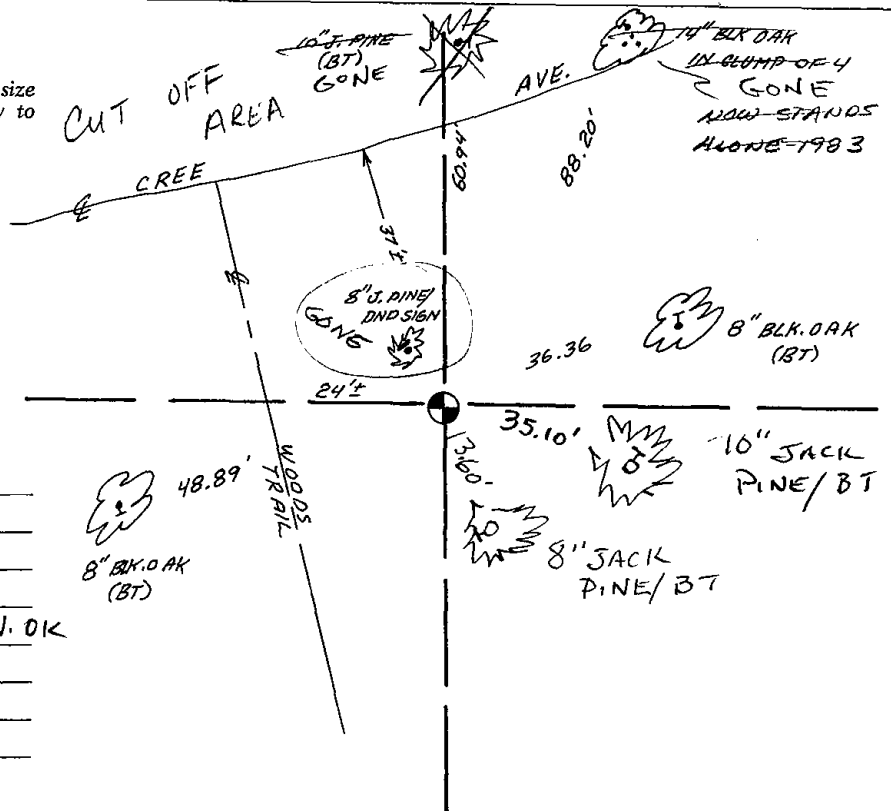

MAINTENANCE RECORD

Date	Init.	Remarks
3-4-83	SS	O.K.
2-23-88	GR-SS	"
8-7-92	JG-BS	2-GONE, 2-NEW, MON. OK
2-25-98	JG	OK
12-17-02	JG	OK
11-27-07	JG	OK