## OF RANGE ADAMS COUNTY

COUNTY CORNER NO: 60

ROMPORTOL ID: 41806132000

## PUBLIC LAND SURVEY MONUMENT RECORD

2-3/8 O.D. IRON PIPE W/ALUMINUM CAP TYPE OF MONUMENT: ADAMS COUNTY COORDINATES, NAD 83 (2007)

N. **242916.688** 

E. 557198.245


ELEVATION- - - -DATUM — — —

FIELD WORK DATE: 01/10/2018


## BASIS FOR MONUMENT LOCATION

1981 - PLS 1167 SEARCHED THE AREA AND FOUND NO EVIDENCE OF THE MONUMENT. CALCULATED THE LOCATION MIDWAY ON A STRAIGHT LINE BETWEEN THE NE CORNER AND THE SE CORNER OF 13-18-6E AND TIED OUT.

2017 - PLS 2994 FOUND A 2-3/8" O.D. IRON PIPE W/ALUMINUM CAP 12" ABOVE THE GROUND SURFACE 1 PROPERTY IRON AND 1 WITNESS TREE. THE MONUMENT AGREES WITH THE EXISTING WITNESS TREE. ACCEPTED THE 2-3/8" O.D. IRON PIPE W/ALUMINUM CAP AS THE CORNER LOCATION. SET 3 NEW TIES AND MEASURED TO THE TIES, PROPERTY IRON AND WITNESS TREE.

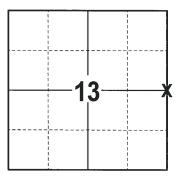

**LOCATION** (INDICATE CORNER BY "X")

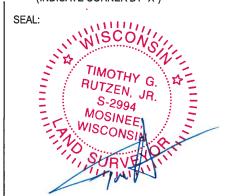

DATA SHOWN HERE ON THIS TIE SHEET IS CORRECT AND COMPLETE TO THE BEST OF MY KNOWLEDGE AND BELIEF.

PROFESSIONAL LAND SURVEYOR


DATE 2-2-18

- TIE SKETCH



- 3/4" x 18" IRON REBAR SET, 1.50#/FT
- 1-1/4" O.D. IRON PIPE FOUND
- 2-3/8" O.D. IRON PIPE W/ALUMINUM CAP FOUND.
- ✓ STEEL FENCE POST H VINYL "T" POST

WITNESS TREE FOUND

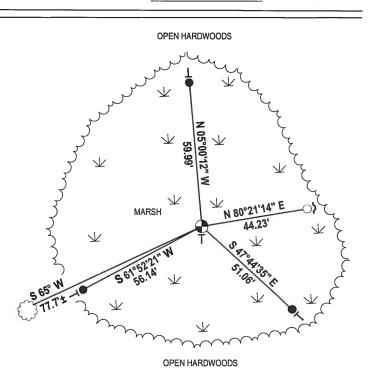

ADAMS	County	CORNER NO. 60
TYPE OF MONUMENT: 2	2"x <b>22</b> " iron pipe 3.65#/ff	section 13
STATE PLANE COORDINATES		TOWN / P
	<u>E</u>	RANGE 6
THETA ANGLE:  LIL	IM:	
FIELD BOOK: LL Basler		<b>1</b>
DRAWN BY:		
		=
BASIS FOR MONUMENT	<del></del>	
Show info such as: History of corr and pg., dates, surveyor; exact	ner, with reference to Vol. description of monument	L L L L L
and pg., dates, surveyor; exact replaced; if location computed, by landowner remarks, etc. (Use reve	taped or EDM traverse; erse side if necessary)	LOCATION (Indicated by 'X')
Searched area, fou	und no evidence of monume	SEAL:
Set Corner midway	on a straight line between	A STATE OF THE STA
NE Cor. & SE Cor.	19-18-61.	
		WAYNE BASI ED
	*	1167
		WIS. RAPIDS, A SE
		TANO CLIMITE COLOR
		OOK O
		WAYNE BASLER 1167 WIS. RAPIDS WIS. SURVE
		CERTIFIED CORRECT:
		Sayku Dasle Registered Land Surveyor
		DATE: May 15, 1981
		DATE:
TIE SKETCH		
Show at least four ties, also fence and type of witness trees' and if	lines, roads, topo, size	
arrive at corner.	TA" ASPEN (	10" B. OAK Blazed
	FACES SOUTH	(3) /
' <i>0</i> 8	NAIL 3 ABOVE GROUND	ly ob
Found		× ale:
NW N€ •	10' 48.2'	- \
<del>-</del>	× 12 ×	<u> </u>
	116.12	DEAD /
14	4" J. Pine Blazed V	TO B. OAK Bloze
	108	
5",	MARIE 17.7 NOT	(D) 2008 6"MAPLE
IS	COON BY	#5 35° E 81.7'
	"14" p. daz/Bla	
ದ್ವದ್ವದ್ಧರಾದ್ಯದ್ದ	something :	I SOUTH
OLEKOBA (A) E	Marie Li. Sign	59.1'
(4/30/8)	SHA L. STYN	59.7
(6/30/8)	AN STAN - LA. STYN	59.7

## MAINTENANCE RECORD

DATE	BY WHOM	REMARKS
3-17-83	GR - SS	O.K.
8-10-92	JG-35 JG-	E-NEW TILS
3-6-98	56	OK
3-6-98 Nov 08	STS	3 NEW TIES
ļ <u></u>		