## D6 RANGE ADAMS COUNTY CORNER NO: 64 ROMPORTOL ID: 41806170020

## PUBLIC LAND SURVEY MONUMENT RECORD

**SURVEY NAIL** TYPE OF MONUMENT: ADAMS COUNTY COORDINATES, NAD 83 (2007)

N. 240028.364

E. 533587.811

**ELEVATION-**DATUM - - -

06/10/2019 FIELD WORK DATE:


## BASIS FOR MONUMENT LOCATION

1972 - PLS 878 FOUND A CONCRETE MONUMENT, REPLACED SAME WITH A HARRISON MONUMENT SET ABOUT 12" BELOW GRADE AND A RAILROAD SPIKE WAS SET ABOVE THE MONUMENT.


YEAR UNKNOWN - PLS 1478 HELD RAILROAD SPIKE AS THE CORNER POSITION.

2014 - PLS 2643 BEFORE THE START OF ROAD CONSTRUCTION THE RAILROAD SPIKE WAS FOUND IN GOOD CONDITION. AFTER THE COMPLETION OF THE ROAD WORK ALONG STATE HIGHWAY 21 THE RAILROAD SPIKE WAS REPLACED BY A SNM 1 BERNTSEN MARKING NAIL AND 4 NEW WITNESS TIES WERE SET TO REFERENCE THE CORNER LOCATION.

2019 - PLS 2675 FOUND SURVEY NAIL IN THE ROAD SURFACE AND 5 TIES. REMOVED THE SURVEY NAIL AND FOUND NO OTHER EVIDENCE OF ANY ADDITIONAL MONUMENTS BELOW. THE SURVEY NAIL LOCATION AGREES WITH ALL 5 TIES. ACCEPTED THE SURVEY NAIL LOCATION AS THE CORNER LOCATION. RESET THE SURVEY NAIL AND MEASURED TO THE EXISTING TIES.

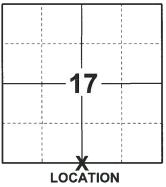

(INDICATE CORNER BY "X")

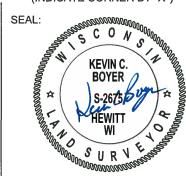

DATA SHOWN HERE ON THIS TIE SHEET IS CORRECT AND COMPLETE TO THE BEST OF MY KNOWLEDGE AND BELIEF.


PROFESSIONAL LAND SURVEYOR

8/2/19

## - TIE SKETCH

NOTE: THE CORNER FALLS 20'± NORTH OF THE CENTERLINE OF STH 21.



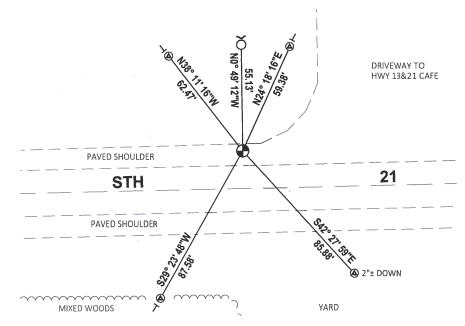

- SET BERNTSEN SSDR103 W/BRONZE CAP
- FOUND 3/4" IRON ROD
  - FOUND SURVEY NAIL MONUMENT
- STEEL FENCE POST
- VINYL "T" POST

	(6)
ADAMS COUNTY	CORNER NO
Survey Monument Record	SECTION
TYPE OF MONUMENT: CONCERN R.R. SOIKE '9	78 TOWN
STATE PLANE COORDINATES: N	RANGE 6
F	
ELEVATION — M.S.L. DATUM:	
THETA ANGLE:	
FIELD BOOK: 103 PAGE 148	
BASIS FOR MONUMENT LOCATION	
(Use reverse side if necessary)	<u> </u>
Show info such as: History of corner, with reference to Vol. and pg, dates, surveyor; exact description of monument replaced; if location computed, by taped or EDM traverse; landowner remarks, etc.	LOCATION (Indicated by 'X') SEAL:
Telliatics, etc.	-1/4/4/11/1/V
_	ANTHONY B. KIEDROWSKI S-878 Wisconsin Rapids. Wis.
Found concrete monument stamped 1/2 Corner	Sul State of the sulphing of t
July 31, 1972	ANTHONY B. KIEDROWSKI
	S-878
Anthony B. Kiedrowski R.L.S. 878	Wisconsin Rapids, Wisc
•	
	And Single Brown
	ANTHONY B. KIEDROWSKI S-878 Wisconsin Rapids. Vis.
0K 7-18-78 PK-SS	
3 7 8 5	
" Z-23-88 GR-S-S	CERTIFIED CORRECT:
11 7-29-92 JG-35	Registered Lond Surveyor
SET R.R. SPIKE 4-23-98 JG-SS BASED ON CSN'S TO SOUTH	DATE: 2-2-73
TIE SKETCH TIES OK 1-22-03 RR. SPIKE Q GANE	R-36 NOTE: MONUMENT BURISD
(Show at least four ties)	GONE 12 DEGA
12" FACK RE STITE	O AR SPIKE CLACK/GT
N N	P.K. EAST
	SIDE POWER OFR SPIKE
3/4" P	D' DAK 13" SLACK
3/4" ROD SET 66.90, 1	GONE OT
y -16' <sup>₹</sup> →	· · · · · · · · · · · · · · · · · · ·
<i>¾</i>	-,18
	<u>€ 3197€ HWY."21"</u>
\$\\\\\\\\\\\\\\\\\\\\\\\\\\\\\\\\\\\\\	WET CON amar
Nail in	13° ± SAST S NORTH
POWER POLE	NORTH
, , , , , , , , , , , , , , , , , , , ,	