O6 RANGE ADAMS COUNTY COUNTY CORNER NO: 65 ROMPORTOL ID: 41806170000

PUBLIC LAND SURVEY MONUMENT RECORD

SURVEY NAIL TYPE OF MONUMENT: ADAMS COUNTY COORDINATES, NAD 83 (2007)

N. 240071.263

E. 536190.219

ELEVATION-DATUM

06/06/2019 FIELD WORK DATE:

BASIS FOR MONUMENT LOCATION


2014 - PLS 2643 RECALLS THE MOST RECENT TIE SHEET OF RECORD WAS FILED BY DALE HAGEN ON JANUARY 2, 1978. AT THAT TIME A P.K. NAIL WAS SET AT THE CORNER POSITION. SINCE THEN THE CORNER HAS BEEN VISITED NUMEROUS TIMES BY LOCAL SURVEYORS AS SHOWN ON THE MAINTENANCE RECORD. ON THE MAINTENANCE ON JANUARY 22, 2003 A MAG NAIL WAS IDENTIFIED AS THE CORNER.

2014 - PLS 2643 PRIOR TO THE CONSTRUCTION ON HIGHWAY 21 THE MAG NAIL WAS RECOVERED AND IDENTIFIED AS THE CORNER LOCATION. AFTER THE COMPLETION OF THE HIGHWAY CONSTRUCTION A SNM 1 BERNTSEN NAIL WAS SET AT THE CORNER LOCATION AND 4 NEW WITNESS TIES WERE SET TO REFERENCE THE CORNER LOCATION.

2019 - PLS 2675 FOUND SURVEY NAIL AND 4 TIES. REMOVED THE SURVEY NAIL AND FOUND NO OTHER EVIDENCE OF ANY ADDITIONAL MONUMENTS BELOW. THE SURVEY NAIL LOCATION AGREES WITH ALL 4 TIES. ACCEPTED THE SURVEY NAIL LOCATION AS THE CORNER LOCATION. RESET THE SURVEY NAIL AND MEASURED TO THE EXISTING TIES.



(INDICATE CORNER BY "X")

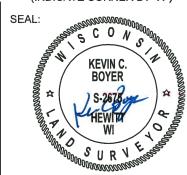

DATA SHOWN HERE ON THIS TIE SHEET IS CORRECT AND COMPLETE TO THE BEST OF MY KNOWLEDGE AND BELIEF.


PROFESSIONAL LAND SURVEYOR

8/2/19

- TIE SKETCH

NOTE: THE CORNER FALLS ON THE CENTERLINE OF STH 21 AND 6'± EAST OF THE CENTERLINE OF 11TH AVE.



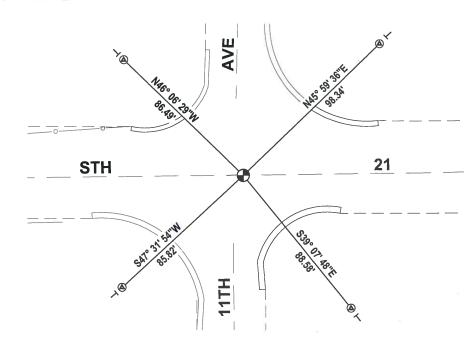



FOUND SURVEY NAIL MONUMENT

VINYL "T" POST

Government Land Corner Certificate CORNER NO. **ADAMS** County SECTION TYPE OF MONUMENT: PK Nail in Pavement 18 N TOWN STATE PLANE COORDINATES: N_{-} 6 E RANGE ELEVATION — M.S.L. DATUM: _ THETA ANGLE: FIELD BOOK: <u>57</u> SECTION DRAWN BY: _ 6 BASIS FOR MONUMENT LOCATION Show info such as: History of corner, with reference to Vol. and pg., dates, surveyor; exact description of monument replaced; if location computed, by taped or EDM traverse; LOCATION landowner remarks, etc. (Use reverse side if necessary) (Indicated by 'X') SEAL: MAN SCONS VILLE Ran EDM/T2 traverse around Section 16 and parts of adjoining Sections to determine HA S-110. Wisconsin Rapiu. Wis. search area for investigation. Did not excavate with backhoe because search area falls within the construction area of State Trubk Highway '21! Prorated between the North Quarter corner of Section 20 and the Northeast corner of Section 21, and set this corner on the centerline of S.T.H. '21', thereby matching occupation and original distances to the South, but am about 19 feet short of the DATA SHOWN HERE ON original distance to the West Quarter corner CERTIFIED CORRECT: of Section 16. Set PK on 10-17-1977. Registered Land Surveyor 1978 January TIE SKETCH Power Pole Show at least four ties, also fence lines, roads, topo, size and type of witness trees' and if off road - best way to NAIL/DISC arrive at corner. NOTE UNKNOWN Ties in trees to PK ± 0.31 nail in disc. LOWER R/W POST 3-21-00 Centerline of MAINTENANCE RECORD C SM

~			
Date	Init.	Remarks	
3-4-83	SS	OK	Power Pole
2.23.88	6R-55	, ,,	CONE
7-29-92	JG-BS	OK.	
2-11-98	JG	OK	
1-22-03	56	2-GONE, 2-NEW	, MAG NAIL @ CORNER
11-27-07	56	ax '	

Power Pole