## 06 RANGE ADAMS COUNTY COUNTY CORNER NO: 66 ROMPORTOL ID: 41806160020


### PUBLIC LAND SURVEY MONUMENT RECORD

**SURVEY NAIL** TYPE OF MONUMENT: ADAMS COUNTY COORDINATES, NAD 83 (2007) N. 240090.439 E. 538826.782 DATUM - - -**ELEVATION-**06/10/2019 FIELD WORK DATE:


### **BASIS FOR MONUMENT LOCATION**

2014 - PLS 2643 RECALLS THE MOST RECENT TIE SHEET OF RECORD WAS CERTIFIED BY G. RHINEHART ON SEPTEMBER 12, 2013. ON THAT TIE SHEET A HARRISON MONUMENT IS IDENTIFIED AS THE CORNER. PRIOR TO THE CONSTRUCTION ON HIGHWAY 21 THE HARRISON MONUMENT WAS NOT RECOVERED. THE CORNER POSITION WAS RE-ESTABLISHED BY USING THE EXISTING WITNESS TIES ON THE NORTH SIDE OF HIGHWAY 21. AFTER THE COMPLETION OF THE HIGHWAY 21 CONSTRUCTION A SNM 1 BERTSEN MARKING NAIL WAS SET AT THE CORNER POSITION AND 4 NEW WITNESS MONUMENTS WERE SET TO REFERENCE THE CORNER POSITION.

2019 - PLS 2675 FOUND SURVEY NAIL IN THE ROAD SURFACE AND 4 TIES, REMOVED THE SURVEY NAIL AND FOUND NO OTHER EVIDENCE OF ANY MONUMENT BELOW. THE SURVEY NAIL LOCATION AGREES WITH ALL 4 TIES. ACCEPTED THE SURVEY NAIL LOCATION AS THE CORNER LOCATION. RESET SURVEY NAIL AND MEASURED TO THE EXISTING TIES.

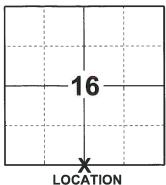

(INDICATE CORNER BY "X")

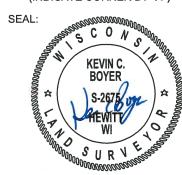


DATA SHOWN HERE ON THIS TIE SHEET IS CORRECT AND COMPLETE TO THE BEST OF MY KNOWLEDGE AND BELIEF.

PROFESSIONAL LAND SURVEYOR

### -TIE SKETCH

NOTE: THE CORNER FALLS 1'± NORTH OF THE CENTERLINE OF STH 21.



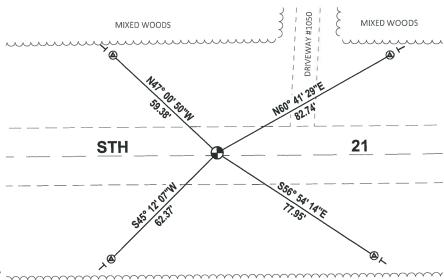

MIXED TREE LINE

FOUND BERNTSEN SSDR103 W/BRONZE CAP


FOUND SURVEY NAIL MONUMENT

VINYL "T" POST

### Government Land Corner Certificate

ADAMS	County
TYPE OF MONUMENT: PK Nail	in Pavement
STATE PLANE COORDINATES: N_	
<u>E</u>	
ELEVATION — M.S.L. DATUM:	
THETA ANGLE:	
FIELD BOOK:	
DRAWN BY: SCOTT SORENSEA	/

# CORNER NO. 66 SECTION 16 TOWN 18 RANGE 6

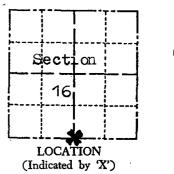

### BASIS FOR MONUMENT LOCATION


Show info such as: History of corner, with reference to Vol. and pg., dates, surveyor; exact description of monument replaced; if location computed, by taped or EDM traverse; landowner remarks, etc. (Use reverse side if necessary)

Ran EDM/T2 traverse around Section 16 and parts of adjoining sections to determine search area for investigation.

Search area falls in pavement of S.T.H. '21', no excavation was made. Could find no evidence of accessory monuments, or resurveys.

Relocated corner by single proportionate measure between adjacent corners.
on line

Set Harrison monument on 10-17-77.

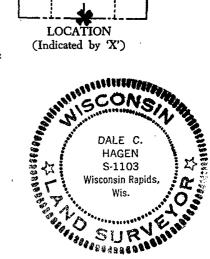

DATA SHOWN HERE ON CERTIFIED CORRECT

Registered Land Surveyor

DATE: 12-6-1977

SEAL:

### TIE SKETCH

Show at least four ties, also fence lines, roads, topo, size and type of witness trees' and if off road - best way to arrive at corner.

#### NOTE

Ties in trees to nail in disc.

### MAINTENANCE RECORD

Date	Init.	Remarks
11-30-78	RN-DA	OK
3-4-83	55	OK
2·z-88	6R-22	ZTIES GONE - Z NEW
7-30-92	<b>5</b> 6-85	0. K.
2-11-98	IJĞ	OK
-22-03		1-GONE 4-NEW
2-20107	JG 35	OK
REVISED 197	7	

