# ADAMS COUNTY COUNTY COUNTY CORNER NO: 67 ROMPORTOL ID: 41806160000

## PUBLIC LAND SURVEY MONUMENT RECORD

**SURVEY NAIL** TYPE OF MONUMENT: ADAMS COUNTY COORDINATES, NAD 83 (2007)

N. **240109.347** 

E. 541463.237


**ELEVATION-**DATUM

06/10/2019 FIELD WORK DATE:

### BASIS FOR MONUMENT LOCATION

2014 - PLS 2643 RECALLS THE MOST RECENT TIE SHEET OF RECORD WAS CERTIFIED BY G. RHINEHART ON SEPTEMBER 12, 2013. THE CORNER POSITION IS IDENTIFIED AS A P.K. NAIL. PRIOR TO THE CONSTRUCTION ON HIGHWAY 21 THE CORNER WAS VISITED AND A MAG NAIL WAS FOUND AND IDENTIFIED AS THE CORNER POSITION. AFTER THE COMPLETION OF THE ROAD CONSTRUCTION A SNM 1 BERNTSEN MARKING NAIL WAS SET IN PLACE OF THE FOUND MAG NAIL. 4 NEW WITNESS MONUMENTS WERE SET TO REFERENCE THE CORNER POSITION.

2019 - PLS 2675 FOUND SURVEY NAIL IN THE ROAD SURFACE AND 4 TIES. REMOVED THE SURVEY NAIL AND FOUND NO ADDITIONAL EVIDENCE OF ANY ADDITIONAL MONUMENTS BELOW. THE SURVEY NAIL LOCATION AGREES WITH ALL 4 TIES. ACCEPTED THE SURVEY NAIL AS THE CORNER LOCATION. RESET AND MEASURED TO THE EXISTING TIES.

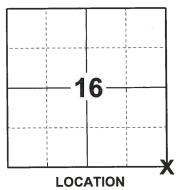

(INDICATE CORNER BY "X")



DATA SHOWN HERE ON THIS TIE SHEET IS CORRECT AND COMPLETE TO THE BEST OF MY KNOWLEDGE AND BELIEF.


PROFESSIONAL LAND SURVEYOR

DATE

### - TIE SKETCH

NOTE: THE CORNER FALLS 6'± NORTH OF THE CENTERLINE OF STH 21.



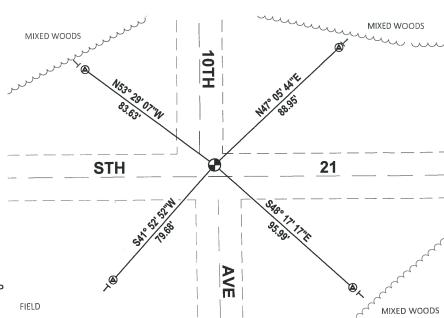

- FOUND BERNTSEN SSDR103 W/BRONZE CAP
- FOUND SURVEY NAIL MONUMENT
- VINYL "T" POST

#### Government Land Corner Certificate CORNER NO. ADAMS County 22 SECTION TYPE OF MONUMENT: P.K. NAIL IN BITUMINOUS 18 TOWN STATE PLANE COORDINATES: N. E. RANGE ELEVATION — M.S.L. DATUM: THETA ANGLE: \_ FIELD BOOK: . \_ PAGE \_ DRAWN BY: SCOTT SORENSEN BASIS FOR MONUMENT LOCATION Show info such as: History of corner, with reference to Vol. and pg., dates, surveyor; exact description of monument replaced; if location computed, by taped or EDM traverse; landowner remarks, etc. (Use reverse side if necessary) LOCATION RAFFER TO A STATE OF THE STATE SEAL: Set by retracing survey by M.C. Smith done in 1911 located in the SW Quarter of Section 15-18-6. ANTHONY B. **KIEDROWSKI** S-878 Wisconsin Rapids Wis. SUP SUP DATA SHOWN HERE ON CERTIFIED CORRECT: Registered Land Surveyor DATE: TIE SKETCH GONE 98' Show at least four ties, also fence lines, roads, topo, size and type of witness trees' and if off road - best way to arrive at corner. CONE 98 NWCOR ELEC. BOX 165.40 MAINTENANCE RECORD *"2/"* Date Init. Remarks 3-4-83 55 1 NEW 715 Z- Z-88 GR-SS OK 7-30-92 56-BS 1-GONE I-NEW MON OK, IRON ROD GONE, 3-NEW MON.OK -2-03 OK NORTHEAST -22-03 IJĠ 2-NEW CORNER 12-20-01 56-55 SIGN POST

SET MAG NAIL TE

REVISED 1977