ADAMS COUNTY COUNTY COUNTY CORNER NO: 72

ROMPORTOL ID: 41806130020

PUBLIC LAND SURVEY MONUMENT RECORD

SURVEY NAIL TYPE OF MONUMENT: ADAMS COUNTY COORDINATES, NAD 83 (2007)

N. 240229.814

E. 554582.232

ELEVATION-DATUM


FIELD WORK DATE:_ 06/05/2019

BASIS FOR MONUMENT LOCATION


1979 - PLS 1478 FOUND HARRISON MONUMENT.

2014 - PLS 2643 PRIOR TO THE ROAD CONSTRUCTION ON HIGHWAY 21 THE CORNER WAS NOT RECOVERED AND THE TIES WERE GONE OR OVERGROWN. RESEARCHED THROUGH THE ADAMS COUNTY SURVEY RECORDS AND FOUND CSM 3852. RETRACED THE CORNER POSITION OF THE CSM AND THEN CALCULATED THE POSITION OF THE CORNER. AFTER THE COMPLETION OF THE ROAD CONSTRUCTION A SNM 1 BERNTSEN MARKING NAIL WAS SET AND 4 NEW WITNESS MONUMENTS WERE SET TO REFERENCE THE CORNER POSITION.

2019 - PLS 2675 FOUND SURVEY NAIL IN THE ROAD SURFACE, REMOVED AND DID NOT FIND ANY EVIDENCE OF ANY ADDITIONAL MONUMENTS BELOW AND 4 TIES. THE SURVEY NAIL LOCATION AGREES WITH THE EXISTING TIES. ACCEPTED THE SURVEY NAIL AS LOCATION AS THE CORNER LOCATION. RESET A SURVEY NAIL IN THE CORNER LOCATION AND MEASURED TO THE EXISTING TIES.

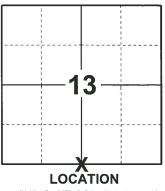

(INDICATE CORNER BY "X")

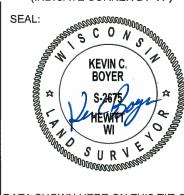

DATA SHOWN HERE ON THIS TIE SHEET IS CORRECT AND COMPLETE TO THE BEST OF MY KNOWLEDGE AND BELIEF.


PROFESSIONAL LAND SURVEYOR

DATE

- TIE SKETCH

NOTE: THE CORNER FALLS 2.5'± NORTH OF THE CENTERLINE OF STH 21.



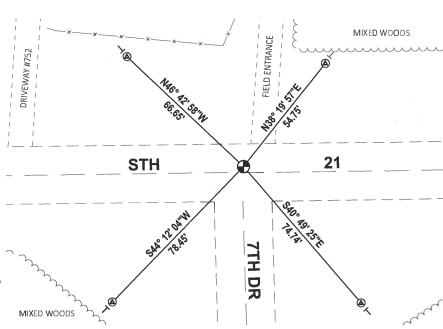

FOUND BERNTSEN SSDR103 W/BRONZE CAP

FOUND SURVEY NAIL MONUMENT

VINYL "T" POST

Government Land Corner Certificate	CORNER NO
County	SET SECTION 13
TYPE OF MONUMENT: HARRISON TEMP PK	TOWN
STATE PLANE COORDINATES: N	range 6
ELEVATION — M.S.L. DATUM:	
FIELD BOOK: 54 PAGE 58	
DRAWN BY: B. SULLIVAN	_ - - - - - - - - - - - - - - - - -
BASIS FOR MONUMENT LOCATION	
Show info such as: History of corner, with reference to Vol. and pg., dates, surveyor; exact description of monument replaced; if location computed, by taped or EDM traverse; landowner remarks, etc. (Use reverse side if necessary)	LOCATION (Indicated by 'X')
The leastion of this comes we determined to be	
The location of this corner was determined to be on a straight line between adjacent section corners at the intersection of the centerline of 7th Drive, by comparisons to distances recorded by M.C. Smith	GREGORY P. RHINEHART S-1478 Wisconsin Rapids Wis.
(ACSR Vol.2 pg. 24) and the D.o.t. (F.B 4151 and STH "21" plans from 1939). Excavation was not att in "21". I was unable to find any evidence of the	RHINEHART S-1478 Wisconsin Rapids Wis.
B.T. marked by Smith.	AND SURVE INTO
	2011111110000000
	DATA SHOWN HERE ON CERTIFIED CORRECT:
	Siegon P Rhulant
	Registered Land Surveyor DATE: 7/10/79
	CONE
TIE SKETCH Show at least four ties, also fence lines, roads, topo, size and type of witness trees' and if off road - best way to arrive at corner.	3-23-00 12" 72" RED
B.J.	DAK B.T.
NAIL STILL GOOD) SET 314"ROD 1.	78.70
@ 24"Srump 35 3-23-00	5 th -
ST. HWY.	# # <u>**</u> <u>**</u> <u>**</u> <u>**</u> <u>**</u> <u>**</u> <u>**</u> <u></u>
a fortis	
A A A A A A A A A A A A A A A A A A A	10° 18° 00° 1
3-23-00 SET 3,	4"800 41 (3)
12" JACK 4" + NE PINE B.T. 6"BIRC,	* * * * * * * * * * * * * * * * * * * *

MAINTENANCE RECORD

DATE	BY WHOM	REMARKS
<u>3-4-83</u>	es est	1 TIE GONE
3-17-83	GR-55	I NEW TIE TAKEN
2-12-88	6R-85	OK .
7-30-92	JG-85	OK
3-6-98	JG	OK
1-22-03	JG	TIES OK
12.20-07	J6-55	TIES OK 2-CONE 3-LEFT
		,
	•	