OS ADAMS COUNTY

COUNTY CORNER NO: 80

ROMPORTOL ID: 41805242000


PUBLIC LAND SURVEY MONUMENT RECORD

HARRISON TYPE OF MONUMENT: ADAMS COUNTY COORDINATES, NAD 83 (2007) N. **237341.365** E. 525736.025 ELEVATION-DATUM - - - -12/21/2017 FIELD WORK DATE:


BASIS FOR MONUMENT LOCATION

1978 - PLS 1478 CALCULATED POSITION PROPORTIONATE AND ON A LINE BETWEEN ADJACENT CORNERS ON THE RANGE LINE. EXCAVATED WITH A BACKHOE BY A.B. KIEDROWSKI AND YIELDED NO EVIDENCE OF ANY PREVIOUS MONUMENTATION. SET A HARRISON MONUMENT AT THE CORNER LOCATION AND TIED OUT.

2017 - PLS 2994 FOUND A HARRISON MONUMENT 12" BELOW THE ROAD SURFACE, FOUND NO EVIDENCE OF ANY TIES OR WITNESSES. ACCEPTED THE HARRISON MONUMENT AS THE BEST EVIDENCE OF THE CORNER LOCATION. SET 4 NEW TIES AND MEASURED TO THE TIES.

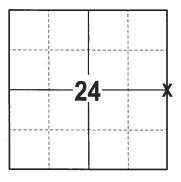

LOCATION (INDICATE CORNER BY "X")

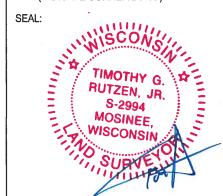

DATA SHOWN HERE ON THIS TIE SHEET IS CORRECT AND COMPLETE TO THE BEST OF MY KNOWLEDGE AND BELIEF.

PROFESSIONAL LAND SURVEYOR

DATE

- TIE SKETCH

NOTE: THE CORNER FALLS 1'± WEST OF THE CENTERLINE OF 14TH AVE.



MIXED WOODS MIXED WOODS DWY MIXED WOODS MIXED WOODS

● 3/4" x 18" IRON REBAR SET, 1.50#/FT HARRISON FOUND

→ VINYL "T" POST

Government Land Corner Certificate


ADAMS		Count	у			
TYPE OF MONUMENT:	e g et	spike to	be	replace	d wi	th
STATE PLANE COORDINATES:	N_	<u> Harrison</u>	in	<u>Spring</u>	of '	79
	E	·				
ELEVATION — M.S.L. DATUM:		· · · · · · · · · · · · · · · · · · ·				
THETA ANGLE:						
FIELD BOOK:5>		PAGE	82	· · ·		
DRAWN BY: S. SORENSEN				·		

BASIS FOR MONUMENT LOCATION

Show info such as: History of corner, with reference to Vol. and pg., dates, surveyor; exact description of monument replaced; if location computed, by taped or EDM traverse; landowner remarks, etc. (Use reverse side if necessary)


Set proportionate and on line between adjacent corners on the range line. Excavation with backhoe by A. B. Kiedrowski yeilded no evidence of any previous monumentation.

CORNER NO. SECTION TOWN

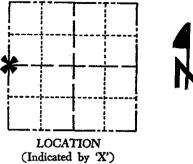

SEAL:

RANGE

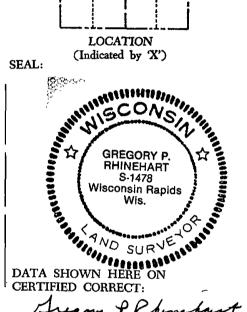


& Rhenedon Registered Und Surveyor

- 22 - 78 DATE:

TIE SKETCH

Show at least four ties, also fence lines, roads, topo, size and type of witness trees' and if off road - best way to arrive at corner.

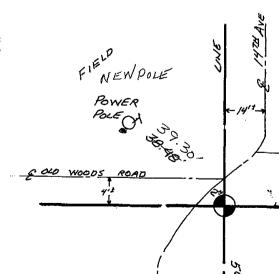

<u>EIRELANG</u>

>F.80.

NO. TRESP. SIGN

5"BLACK

NEW BLK OAK

MAINTENANCE RECORD

	· · · · · · · · · · · · · · · · · · ·			
Date	Init.	Remarks		
34-83	22	O.K.		
z-11-88	6R-55.	OK		
7-29-92	JG-BS	2-GONE-, 2-NEW MON OK		
2-3-98	56	ALL OK		
12-16-02	76	OK		
11-21-07	15-55	OK		

OAK/OT