

20 SECTION 18 TOWN 06 RANGE

# ADAMS COUNTY

COUNTY CORNER NO: 84  
ROMPORTOL ID: 41806200020

## PUBLIC LAND SURVEY MONUMENT RECORD

TYPE OF MONUMENT: HARRISON  
ADAMS COUNTY COORDINATES, NAD 83 (2007)

N. 234760.298

E. 533572.131

ELEVATION- \_\_\_\_\_ DATUM \_\_\_\_\_


FIELD WORK DATE: 06/13/2019

### BASIS FOR MONUMENT LOCATION

1974 - PLS 1103 SET HARRISON EQUIDISTANT AND ON LINE BETWEEN ADJACENT SECTION CORNERS.

1988 - PLS 1321 FOUND HARRISON MONUMENT AND SET NEW TIES.


2019 - PLS 2675 FOUND A HARRISON MONUMENT 4" BELOW THE ROAD SURFACE AND 6 TIES. THE MONUMENT AGREES WITH THE EXISTING TIES. ACCEPTED THE HARRISON MONUMENT AS THE CORNER LOCATION AND RE-MEASURED TO THE EXISTING TIES.

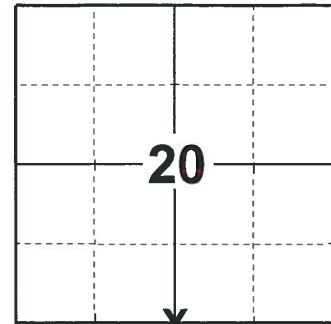

**LOCATION**

(INDICATE CORNER BY "X")

SEAL:

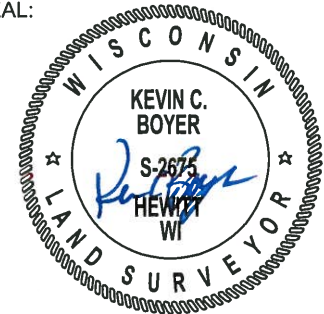


DATA SHOWN HERE ON THIS TIE SHEET IS CORRECT AND COMPLETE TO THE BEST OF MY KNOWLEDGE AND BELIEF.

PROFESSIONAL LAND SURVEYOR

DATE 8/2/19

### - TIE SKETCH

NOTE: THE CORNER FALLS 2± SOUTH OF THE CENTERLINE OF CYPRESS AVE.

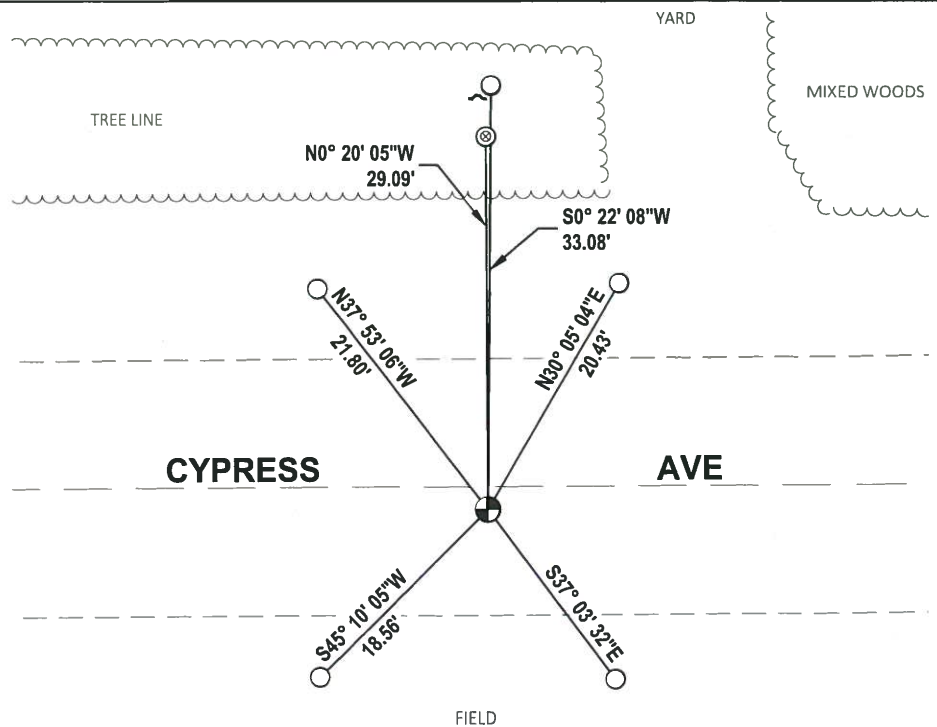

- FOUND 3/4" IRON ROD
- ⊙ FOUND 1-1/2" O.D. IRON PIPE
- ⊕ FOUND HARRISON MONUMENT
- ✓ STEEL FENCE POST

ADAMS COUNTY

Survey Monument Record

TYPE OF MONUMENT: 30" Harrison standard

STATE PLANE COORDINATES: N \_\_\_\_\_


E \_\_\_\_\_

ELEVATION — M.S.L. DATUM: \_\_\_\_\_

THETA ANGLE: \_\_\_\_\_


FIELD BOOK: \_\_\_\_\_ PAGE \_\_\_\_\_

CORNER NO. 560<sup>84</sup>  
SECTION 29  
TOWN 18  
RANGE 6

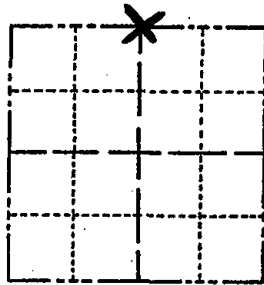

LOCATION  
(Indicated by 'X')

SEAL:

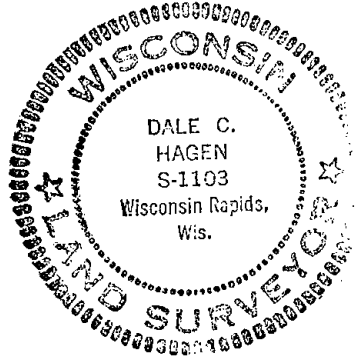

BASIS FOR MONUMENT LOCATION

(Use reverse side if necessary)

Show info such as: History of corner, with reference to Vol. and pg, dates, surveyor; exact description of monument replaced; if location computed, by taped or EDM traverse; landowner remarks, etc.

Set equidistant and on line between adjacent section corners.

- OK 7-18-78 PK-SS
- " 3-4-83 SS
- " 2-12-88 GR-SS
- " 7-28-92 JG-BS
- DK 2-2-98 - JG

OK-12-2-02 SS

CERTIFIED CORRECT:


Dale C. Hagen  
Registered Land Surveyor

DATE: 10-28-74

TIE SKETCH OK, 11-15-02-JG-SS

(Show at least four ties)

• = 3/4" ROD SET BY J.G.V. 4-11-88  
(SEE ATTACHED PAGE)

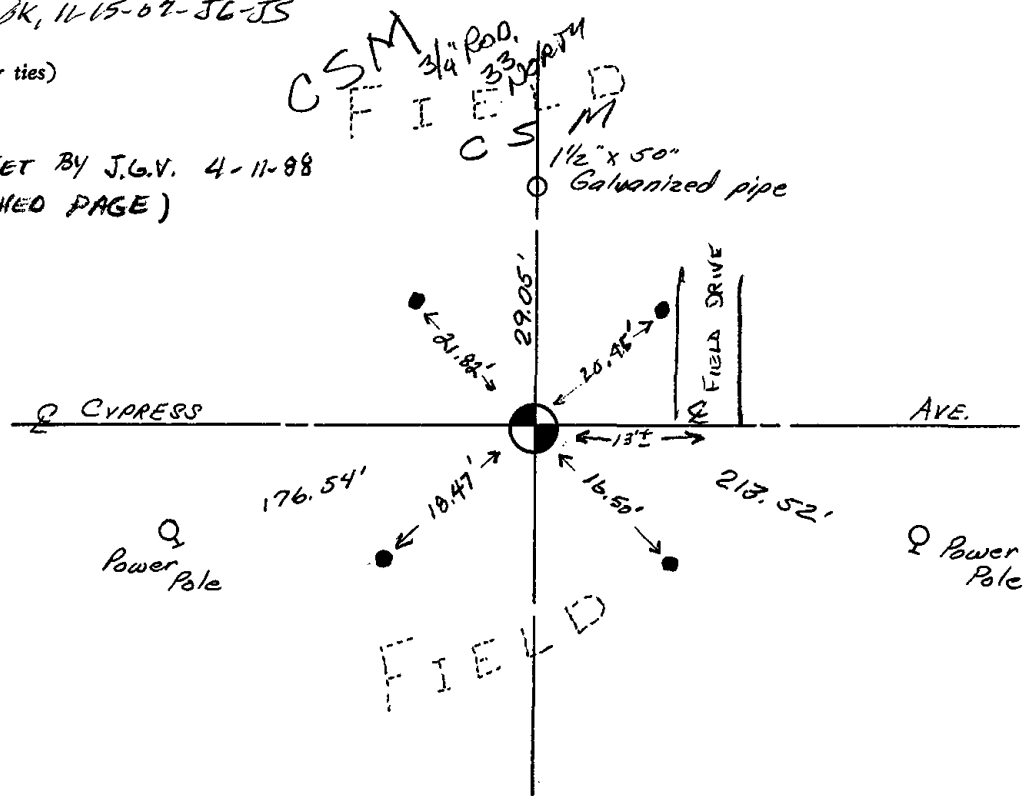


# U. S. PUBLIC LAND SURVEY MONUMENT RECORD

## ADAMS COUNTY

**INSTRUCTIONS:** This record shall show the location of the corner and shall include all of the following nine elements (a through i).

- (a) Identify the corner by reference to the U.S. public land survey system.  
 ○ = Corner monument restored.

*N 1/4 CORNER  
 SECTION 29  
 T 18 N R 6 E  
 TOWN OF PRESTON  
 ADAMS Co., WIS*


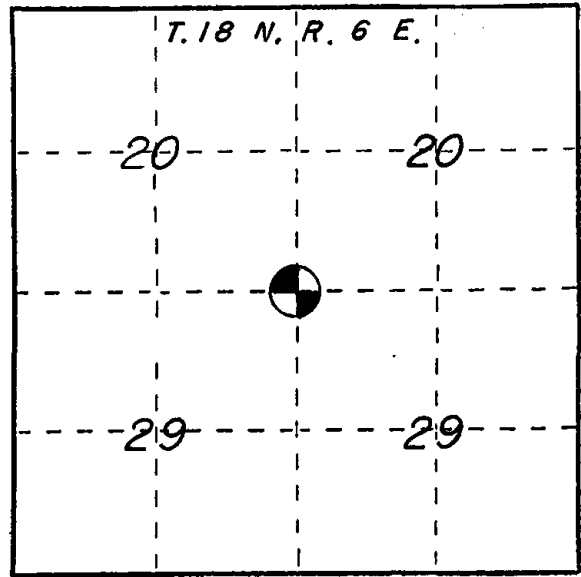


- (b) Describe any record evidence, monument evidence, occupational evidence, testimonial evidence or any other material evidence you considered, and whether the monument was found or placed.

*FOUND HARRISON MON. AND SET NEW TIES AS SHOWN BELOW.*

- (c) In the plan view drawing below, provide reference ties to at least 4 witness monuments, or, if the location is within a municipality, to at least 2 witness monuments. (Witness monuments shall be made of concrete, natural stone, iron or other equally durable material.) Describe witness monuments.

- (d) Show a plan view drawing depicting the relevant monuments and reference ties which is sufficient in detail to enable accurate relocation of the corner monument if the corner monument is disturbed. Indicate north.

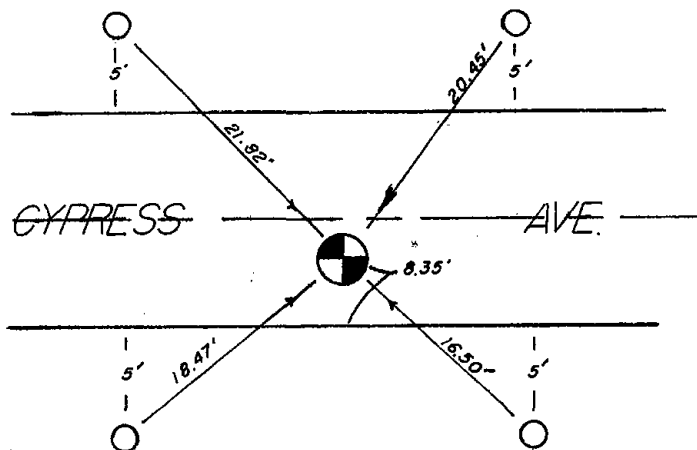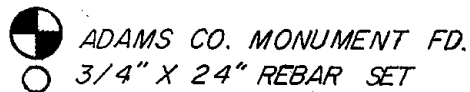

NO SCALE


(e) Describe any material discrepancy between the location of the corner as restored or reestablished and the location of that corner as previously restored or reestablished by distance and direction. Show the discrepancy on the plan view drawing under (d), above. Show the distances between the corner as previously restored or reestablished and (1) the corner as restored or reestablished, and (2) to at least 2 of the witness monuments shown on the drawing in (d), above.

NONE

(f) Was the corner restored through acceptance of (1) an obliterated evidence location, or, (2) a found perpetuated location?

(g&h) Was the corner reestablished through lost corner proportionate methods? If so, show the method, including the directions and distances to other public land survey corners used as evidence or used for proportioning in determining the corner location?

NO

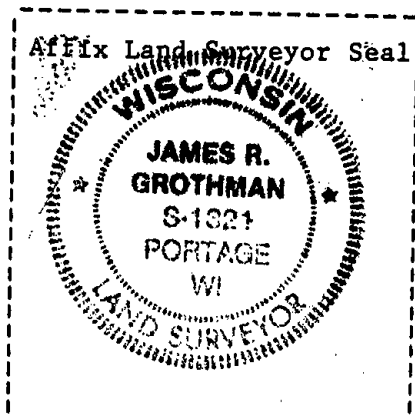

(i) JAMES R. GROTHMAN  
(type or print name) certify that the corner location shown on this record was determined by me or under my direction and control and that this U.S. Public Land Survey Monument Record is correct and complete to the best of my knowledge and belief.

James R. Grothman  
Signature

9/15/88  
Date