# 06 RANGE ADAMS COUNTY COUNTY CORNER NO: 85 ROMPORTOL ID: 41806200000

## PUBLIC LAND SURVEY MONUMENT RECORD

**HARRISON** TYPE OF MONUMENT: ADAMS COUNTY COORDINATES, NAD 83 (2007)

N. 234792.787

E. 536218.574

**ELEVATION-**DATUM

FIELD WORK DATE: 06/13/2019

#### **BASIS FOR MONUMENT LOCATION**

1974 - PLS 1103 A KIEDROWSKI EXCAVATED WITH BACKHOE AND FOUND 2" O.D. IRON PIPE. ACCEPTED AS CORRECT AND MONUMENTED WITH A HARRISON. NOTICED STUMP FROM WHAT OLD TIME ADJACENT LANDOWNER SAID WAS A BEARING TREE. A SEARCH OF THE ORIGINAL NOTES IN THE COURT HOUSE, DNR RECORDS AT MADISON, AND AT THE RECORDS OF THE EASTERN DIVISION OF THE BUREAU OF LAND MANAGEMENT AT SILVER SPRING, MD. SHOWED NO ORIGINAL BEARING TREES FOR THIS CORNER. VERY UNUSUAL.

2019 - PLS 2675 FOUND A HARRISON MONUMENT 4" BELOW THE ROAD SURFACE AND 1 WITNESS. THE MONUMENT AGREES WITH THE EXISTING WITNESS. ACCEPTED THE HARRISON MONUMENT AS THE CORNER LOCATION. SET 4 NEW TIES AND MEASURED TO THE TIES AND WITNESS.

MIXED WOODS



(INDICATE CORNER BY "X")



DATA SHOWN HERE ON THIS TIE SHEET IS CORRECT AND COMPLETE TO THE BEST OF MY KNOWLEDGE AND BELIEF.

YARD


MIXED WOODS

PROFESSIONAL LAND SURVEYOR

#### - TIE SKETCH -

NOTE: THE CORNER FALLS ON THE CENTERLINE OF CYPRESS AVE AND 1'± EAST OF THE CENTERLINE OF 11TH AVE.



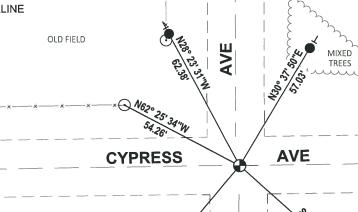

- SET 3/4" x 18" IRON REBAR, 1.50#/FT
- FOUND HARRISON MONUMENT
- R/W FENCE POST
- VINYL "T" POST

### ADAMS COUNTY CORNER NO. SECTION Survey Monument Record TOWN TYPE OF MONUMENT: 30" Harrison standard RANGE STATE PLANE COORDINATES: N\_ ELEVATION — M.S.L. DATUM: \_ THETA ANGLE: \_ FIELD BOOK: \_ \_ PAGE BASIS FOR MONUMENT LOCATION (Use reverse side if necessary) Show info such as: History of corner, with reference to Vol. and pg, dates, surveyor; exact description of monument replaced; if location computed, by taped or EDM traverse; landowner SEAL: Anthony B. Kiedrowski excavated with backhoe and found 2" Iron Pipe. Accepted as correct and monumented same. Notice stump from what old time adjacent landowner said was a bearing tree. A search of the original notes in the Court House, DNR records at Madison, and at the records of the Eastern Div. of the Bureau of Land Management at Silver Spring, Md. showed no original bearing trees for this corner. Very unusual. 7-18-78 CERTIFIED CORRECT: OK 3-8-83 GR-55 2-12-88 Registered Land Surveyo GRANDSON OF LOCAL OLD TIMER BRYAN SORENSEN CHECKED THIS DATE: \_/0-Z8.7 7-28-92 BS-JG-OK CORNER 1-GONE, 1-NEW, 1-22-98- JG TIE SKETCH 1-NEW, MON. OK 12-13-02-56 OK 11-21-07 65-55 (Show at least four ties) 7"BIX Oak /BT 62.50 MAG NAIL IN RR FENCE POST ٠ جي م GONE 98

REVISED 1974

believed to be BT

Pointed out by local
old timer Pete Soron.

"Twin Blk Oak/BT