

24 SECTION 18 TOWN 06 RANGE

ADAMS COUNTY

COUNTY CORNER NO: 93
 ROMPORTOL ID: 41806240000

PUBLIC LAND SURVEY MONUMENT RECORD

TYPE OF MONUMENT: HARRISON
 ADAMS COUNTY COORDINATES, NAD 83 (2007)

N. 234957.991

E. 557325.381


ELEVATION- DATUM

FIELD WORK DATE: 01/11/2018

BASIS FOR MONUMENT LOCATION


1975 - PLS 878 EXCAVATED WITH A BACKHOE AND FOUND A STAIN FROM A 5" DIAMETER POST. NO OTHER EVIDENCE WAS FOUND. ACCEPTED AS THE CORNER LOCATION AFTER VERIFYING LOCATION BY AN EDM TRAVERSE OF THE ENTIRE SECTION. NO RESURVEYS ON RECORD. SET A HARRISON MONUMENT AT THE CORNER LOCATION AND TIED OUT.

2017 - PLS 2994 FOUND A HARRISON MONUMENT 6" BELOW THE GROUND SURFACE AND 2 PROPERTY IRONS. ALL OF THE WITNESSES HAVE BEEN DESTROYED. ACCEPTED THE HARRISON MONUMENT AS THE BEST EVIDENCE OF THE CORNER LOCATION. SET 3 NEW TIES AND MEASURED TO THE TIES AND PROPERTY IRONS.

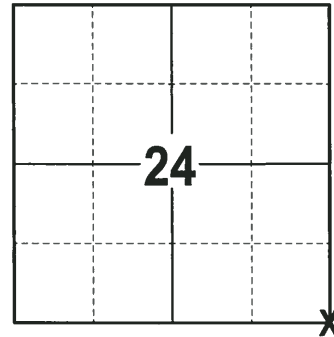

LOCATION
 (INDICATE CORNER BY "X")

SEAL:


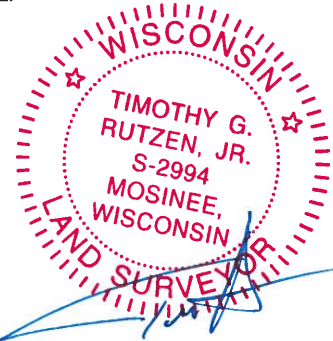


DATA SHOWN HERE ON THIS TIE SHEET IS CORRECT AND COMPLETE TO THE BEST OF MY KNOWLEDGE AND BELIEF.

PROFESSIONAL LAND SURVEYOR

DATE 2-2-18

- TIE SKETCH -

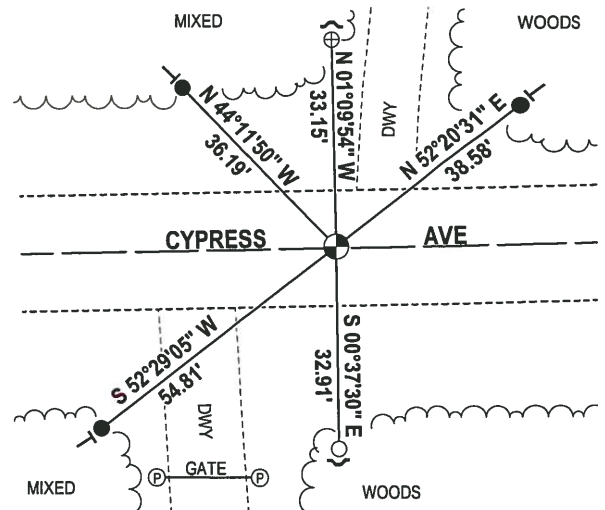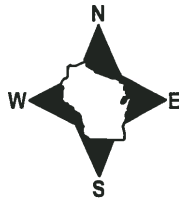

- 3/4" x 18" IRON REBAR SET, 1.50#/FT
- 3/4" IRON ROD FOUND
- ⊕ 1-1/4" O.D. IRON PIPE FOUND
- ⊙ HARRISON FOUND
- ↙ STEEL FENCE POST
- VINYL "T" POST

ADAMS COUNTY

Survey Monument Record

TYPE OF MONUMENT: STANDARD HARRISON

STATE PLANE COORDINATES: N _____
E _____

ELEVATION — M.S.L. DATUM: _____

THETA ANGLE: _____


FIELD BOOK: _____ PAGE _____

CORNER NO. 871 ⁹³

SECTION 25


TOWN 18 N

RANGE 6 E

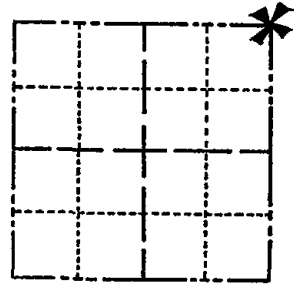

LOCATION
(Indicated by 'X')

SEAL:

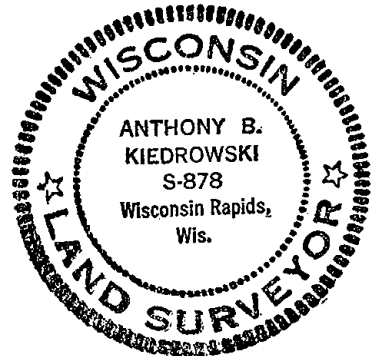

BASIS FOR MONUMENT LOCATION

(Use reverse side if necessary)

Show info such as: History of corner, with reference to Vol. and pg, dates, surveyor; exact description of monument replaced; if location computed, by taped or EDM traverse; landowner remarks, etc.

Excavated with backhoe. Found stain from 5" dia. post. No other evidence. Accepted as corner after verifying location by an EDM traverse of the entire section. No resurveys on record.

- OK 9-12-78 RN-SS
- " 3-2-83 SS
- " 2-12-88 GR-SS
- 1-NEW 7-29-92 JG-BS
- 1-CONE, 2-NEW, 1-22-98-JG
- OK, 12-16-02-JG
- 1-CONE, 2-NEW 11-21-07 CS-SS

CERTIFIED CORRECT:

Anthony B. Kiedrowski

Registered Land Surveyor
10/12/75

DATE: _____

TIE SKETCH

(Show at least four ties)

