06 ADAMS COUNTY COUNTY

ROMPORTOL ID: 41806302000

PUBLIC LAND SURVEY MONUMENT RECORD

HARRISON TYPE OF MONUMENT: ADAMS COUNTY COORDINATES, NAD 83 (2007)

N. 232087.063

E. 530986.646

ELEVATION-DATUM


FIELD WORK DATE: 12/18/2019

BASIS FOR MONUMENT LOCATION

1974 - PLS 1103 SET HARRISON MONUMENT EQUIDISTANT AND ON LINE BETWEEN ADJACENT SECTION CORNERS. AN EXTENSIVE INVESTIGATION IN THE SEARCH AREA REVEALED NO CONCLUSIVE EVIDENCE AS TO THE LOCATION OF THE ORIGINAL CORNER, ALTHOUGH A BEARING TIE FROM THE ORIGINAL NOTES IN ADAMS COUNTY WAS USED TO DETERMINE THE SEARCH AREA, THIS TIE WAS TO THE NORTH END OF ROCHE-A-CRI MOUND. THIS CORNER FALLS IN ROCHE-A-CRI STATE PARK ON THE EAST SIDE OF THE ROCHE-A-CRI MOUND.

2013 - PLS 1478 REDREW TIE SHEET.

2019 - PLS FOUND HARRISON 3" ABOVE THE GROUND AND 2 WITNESS TREES. THE MONUMENT AGREES WITH ONE OF TWO WITNESS TREES. ACCEPTED THE HARRISON AS THE CORNER LOCATION. SET 4 NEW TIRES AND MEASURED TO THE WITNESS TREES.

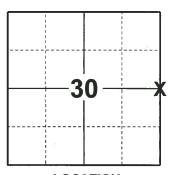

LOCATION

(INDICATE CORNER BY "X")




DATA SHOWN HERE ON THIS TIE SHEET IS CORRECT AND COMPLETE TO THE BEST OF MY KNOWLEDGE AND BELIEF.


PROFESSIONAL LAND SURVEYOR

-TIE SKETCH

NOTE: THE CORNER LANDS 150'± EAST OF BOTTOM OF SLOPE OF A ROCK OUT CROP

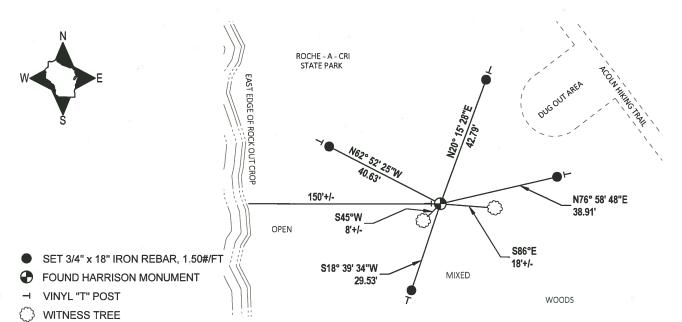

ADAMS COUNTY CORNER NO. -29 SECTION Survey Monument Record 18 TOWN TYPE OF MONUMENT: 30" Harrison standard 6 STATE PLANE COORDINATES: N_ RANGE ELEVATION — M.S.L. DATUM: __ THETA ANGLE: ____ FIELD BOOK: ____ __ PAGE _ BASIS FOR MONUMENT LOCATION (Use reverse side if necessary) LOCATION Show info such as: History of corner, with reference to Vol. and pg, dates, surveyor; exact description of monument replaced; if location computed, by taped or EDM traverse; landowner (Indicated by 'X') Indicated by State of the State SEAL: remarks, etc. Set equidistant and on line between adjacent section corners. DALE C. HAGEN An extensive investigation in the search area S-1103 revealed no conclusive evidence as to the location Wisconsin Rapids of the original corner, although a bearing tie from Wis. the original notes in Adams County was used to determine the search area, this tie was to the North end of Roche-A-Cri Mound. This corner falls in Roche-A-Cri State Park on the East side of the Roche-A-Cri mound.

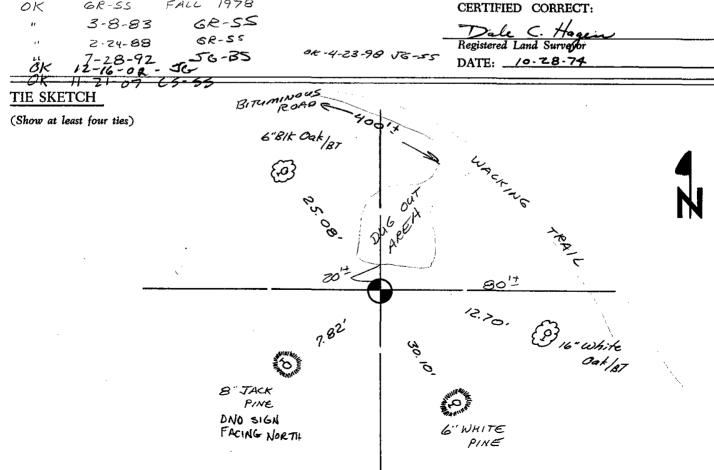

6R-55

OK

FALL 1978