28 SECTION

18 TOWN

## ADAMS COUNTY COUNTY COUNTY CORNER NO: 97 ROMPORTOL ID: 41806282000

### PUBLIC LAND SURVEY MONUMENT RECORD


**HARRISON** TYPE OF MONUMENT: ADAMS COUNTY COORDINATES, NAD 83 (2007) N. 232226.951 E. 541546.860 DATUM 07/01/2019 FIELD WORK DATE:

#### BASIS FOR MONUMENT LOCATION


1974 - PLS 1103 SET HARRISON MONUMENT EQUIDISTANT AND ON LINE BETWEEN ADJACENT SECTION CORNERS. ABK DUG WITH BACKHOE AND FOUND NOTHING AT THE INTERSECTION OF THE FENCE AND THE ROAD.

1992 - PLS 1625 MONUMENT WAS BROKEN OFF BY A PLOW. BOTTOM STILL INTACT. REPLACED WITH NEW HARRISON. MADE NEW BT'S.

2019 - PLS 2675 FOUND A HARRISON MONUMENT FLUSH WITH THE GROUND SURFACE AND 3 WITNESS TREES, THE MONUMENT AGREES WITH THE EXISTING WITNESS TREES. ACCEPTED THE HARRISON MONUMENT AS THE CORNER LOCATION. SET 4 NEW TIES AND MEASURED TO THE TIES AND WITNESS TREES.

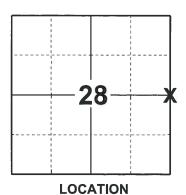

(INDICATE CORNER BY "X")

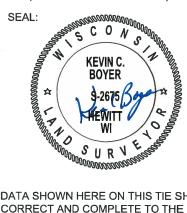

DATA SHOWN HERE ON THIS TIE SHEET IS CORRECT AND COMPLETE TO THE BEST OF MY KNOWLEDGE AND BELIEF.


PROFESSIONAL LAND SURVEYOR

#### -TIE SKETCH

NOTE: THE CORNER FALLS 26'± WEST OF THE CENTERLINE OF 10TH AVE.



- SET 3/4" x 18" IRON REBAR, 1.50#/FT
- FOUND HARRISON MONUMENT
- VINYL "T" POST
- WITNESS TREE

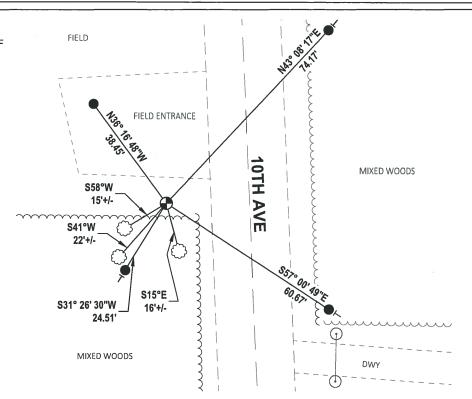

_ADA	MK		County		CORNER NO.	
			ARD HARRISON		SECTION	27
			ALD TIMERI DOIG		TOWN	<u> 18N</u>
					RANGE	_ 6E
ELEVATIO	N — N	I.S.L. DATUM:		<del> </del>		<del></del>
THETA A	NGLE:	1 - 1				!
FIELD BOO	OK:k	AF 40	PAGE	<b></b> -		
DRAWN B	1:			*	27	-
BASIS FO	R MOI	NUMENT LOCA	TION			
Show info s	uch as: F	History of corner, with	h reference to Vol.			i
and pg., dreplaced; if	ates, surv location	reyor; exact descripti computed, by taped tc. (Use reverse side	<u> </u>	LOCATION		
landowner r	emarks, e	tc. (Use reverse side	if necessary)	SEAL:	(Indicated by 'X')	
				on vo.	294	"Trongles
Mono	MEN-	T WAS RR	COKEN OFF BY			100
_		TTOM STILL	<del></del> ,		: ∷ary∎	X
					CVSMER	
			IEW HARRISON.		18	
MADE	NE	w BT's			WI *	· /:
					i	
					SARAN	. see . se edied!
					*******************************	,
				DATA SHO	OWN HERE ON CORRECT:	
				Y T	Connect	
				Registered L	and Surveyor	_
				DATE: K	OTH DECEMB	ER 19
TIE SKET	CH			\ i.i	<i>t</i>	
Show at lea	st four ti	es, also fence lines, r	oads, topo, size		M C	LEAR
arrive at con	rner.	trees' and if off road	- best way to	{ 1	\	
		ı	COLTIVE	\ \ \ /	/ 6"JA	CK PINE
TREES		I)	COLTIVATED	( )	}	AREA
To 200	a SPIK	.es		\ \ \ \ \ \ \ \ \ \ \ \ \ \ \ \ \ \ \	` {	
		ĮĮ.			} ~~~	~~~
		九,	10" WHITE PUE THE	5.45 0 < Z6 ±	Noot	05
		14.	12.61'	' R' _	) no	
_			RD /2" BLK OAK	Ri Person	<i>\</i>	
		ENANCE RECOF		BLACK GAK	{	
Date	Init.	Remark	(ND 8T	- HEW TIE) /	\ \\ \\ \\ \\ \\ \\ \\ \\ \\ \\ \\ \\ \	
7-12-98	IG	4-TIES LETT, N		/ .1	( 4 B	40 JJU
2-13-02 11-26-07	JG Je	VIK, METAL POST, I	UNA TION AT WENTER	1000g	10	
	حب			<u>0</u>		
7 20 07				1	•	
		,			\	

# ADAMS COUNTY

Survey Monument Record

TYPE OF MONUMENT: 30" Harrison standard STATE PLANE COORDINATES: N\_

E....

ELEVATION - M.S.L. DATUM: \_

THETA ANGLE: \_\_\_ FIELD BOOK: \_ \_ PAGE .

BASIS FOR MONUMENT LOCATION

(Use reverse side if necessary)

Show info such as: History of corner, with reference to Vol. and pg, dates, surveyor; exact description of monument replaced; if location computed, by taped or EDM traverse; landowner remarks, etc.

Set equidistant and on line between adjacent section corners.


in chiese ABK dug and found nothing at the inter section of the fence and the road.

CORNER NO.

SECTION

18 TOWN

RANGE

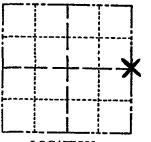

SEAL:

LOCATION
(Indicated by X) DALE C. Comment of the state of the sta HAGEN

PK-SS OK 7-18-78 3-23-83 6R-55 TIE GR-SS 2-2.88

SEE TIE SHEET DATED

CERTIFIED CORRECT:

Registered Land Surveyof

10-28-74 DATE:

TIE SKETCH

(Show at least four ties)

