26 SECTION

ADAMS COUNTY COUNTY COUNTY CORNER NO: 99 ROMPORTOL ID: 41806262000

PUBLIC LAND SURVEY MONUMENT RECORD

BERNTSEN SNM1 SURVEY NAIL TYPE OF MONUMENT: ADAMS COUNTY COORDINATES, NAD 83 (2007)

N. **232272.510**

F. 552048.899


ELEVATION-DATUM

FIELD WORK DATE: 06/27/2019

BASIS FOR MONUMENT LOCATION


2013 - PLS 1199 CORNER LOST DUE TO CONSTRUCTION, CORNER RE-SET USING CSM #1976 AND CSM #2320 AND THE SECTION SUMMARY ON FILE FROM THE COUNTY SURVEYOR'S OFFICE.

2019 - PLS 2675 FOUND A 6" NAIL IN THE ROAD SURFACE, 1 TIE AND 2 WITNESSES. REMOVED THE NAIL AND FOUND NO OTHER EVIDENCE OF ANY ADDITIONAL MONUMENT BELOW. THE 6" NAIL LOCATION AGREES WITH THE EXISTING TIE AND WITNESSES. ACCEPTED THE 6" NAIL LOCATION AS THE CORNER LOCATION. SET A SURVEY NAIL IN THE 6" NAIL LOCATION. SET 4 NEW TIES AND MEASURED TO A FOUND WISDOT ALUM. CAP AND THE EXISTING TIE AND WITNESSES.

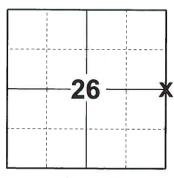

LOCATION

(INDICATE CORNER BY "X")

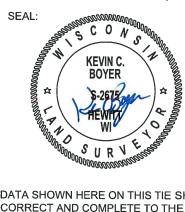

DATA SHOWN HERE ON THIS TIE SHEET IS CORRECT AND COMPLETE TO THE BEST OF MY KNOWLEDGE AND BELIEF.


PROFESSIONAL LAND SURVEYOR

- TIE SKETCH -

NOTE: THE CORNER FALLS 2'± EAST OF THE CENTERLINE OF 8TH AVE.



- SET 3/4" x 18" IRON REBAR, 1.50#/FT
- FOUND 1-1/4" O.D. IRON PIPE
- SET SURVEY NAIL
- ALUM. CAP IN WINGWALL
- VINYL "T" POST

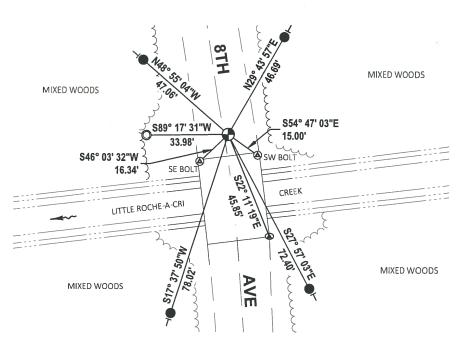

CORNER NO. 942 ADAMS COUNTY SECTION Survey Monument Record TYPE OF MONUMENT: Chiseled Grooves in Bridge Deck. TOWN RANGE STATE PLANE COORDINATES: N. ELEVATION - M.S.L. DATUM: _ THETA ANGLE: . FIELD BOOK: PAGE . BASIS FOR MONUMENT LOCATION (Use reverse side if necessary) LOCATION Show info such as: History of corner, with reference to Vol. and pg, dates, surveyor; exact description of monument replaced; if location computed, by taped or EDM traverse; landowner (Indicated by 'X') SEAL: remarks, etc. Ran EDM/transit traverse around Sectionn25 and to the adjacent corners to determine search areas. Did not excavate because corner search area fell within the bridge construction area. HAGEN S-1103 Wisconsin Rapids, Set corner by single proportional measure between Wis. adjacent section corners. RN-SS OK 9-12-78 3-2-83 - 55 -I TIE GONE - NOTHING CERTIFIED CORRECT: AUAILABLE 2-12-88 GR-SS OK FO P.K. - ADD Z NEW TIES 4-23-98 JG-S Registered Land Surveyor DK, 12-16-02-5G January OK 11-21-07 CS TIE SKETCH CSM (Show at least four ties) NOTE: B"Elm/g Ties in trees to nail in disc. Ties to south edge of iron end post at sides of bridge TIES TO NEW 7.16 44.59. NEZY 5W '2Y Little - Roche ROLT BOLT N Ò

Chieled grooves

in concrete slab at corner

S