# **D6** ADAMS COUNTY

COUNTY CORNER NO: 100

ROMPORTOL ID: 41806252000

# PUBLIC LAND SURVEY MONUMENT RECORD


TYPE OF MONUMENT: **HARRISON** ADAMS COUNTY COORDINATES, NAD 83 (2007) N. **232324.344** E. 557353.036 DATUM FIELD WORK DATE: 01/11/2018

#### BASIS FOR MONUMENT LOCATION

1976 - PLS 1103 RAN EDM/TRANSIT TRAVERSE AROUND SECTION 25 AND TO ADJACENT SECTION CORNERS TO DETERMINE THE SEARCH AREAS FOR INVESTIGATION. COULD FIND NO EVIDENCE OF THE ORIGINAL CORNER OR ANY REMONUMENTATION. SET THE CORNER BY SINGLE PROPORTIONATE MEASUREMENT BETWEEN ADJACENT SECTION CORNERS. SET A HARRISON MONUMENT AND TIED OUT.

2001 - PLS 1478 FOUND THE PRIOR MONUMENT TO BE 8.39' NORTH AND 0.79' WEST OF THE TRUE SINGLE PROPOTIONATE POSITION, RESEARCH INDICATED ALL SURVEYS IN ADJACENT SECTIONS USED A SINGLE PROPORTIONATE POSITION COMPUTATION. MOVED THE MONUMENT TO THE CORRECTED COMPUTED LOCATION AND RE-MEASURED ALL TIES. SET A 3/4" ROD AT THE OLD LOCATION.

2017 - PLS 2994 FOUND A HARRISON MONUMENT 6" ABOVE THE GROUND SURFACE AND 3 WITNESS TREES. THE MONUMENT AGREES WITH THE EXISTING WITNESS TREES. ACCEPTED THE HARRISON MONUMENT AS THE CORNER LOCATION. SET 4 NEW TIES AND MEASURED TO THE TIES AND WITNESS TREES.

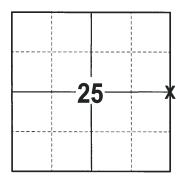

LOCATION (INDICATE CORNER BY "X")


SEAL:



KNOWLEDGE AND BELIEF. PROFESSIONAL LAND SURVEYOR

- TIE SKETCH



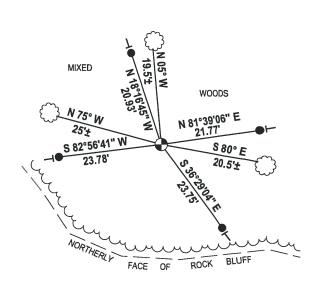

3/4" x 18" IRON REBAR SET, 1.50#/FT HARRISON FOUND VINYL "T" POST WITNESS TREE FOUND

#### **Government Land Corner Certificate** CORNER NO. ADAMS County **SECTION** HARRISON MONUMENT TYPE OF MONUMENT: \_\_ TOWN STATE PLANE COORDINATES: N. **BANGE** ELEVATION — M.S.L. DATUM: \_\_\_ THETA ANGLE: \_\_\_\_\_ PAGE \_\_ FIELD BOOK: \_\_\_\_\_ DRAWN BY: BASIS FOR MONUMENT LOCATION Show info such as: History of corner, with reference to Vol. and pg., dates, surveyor; exact description of monument replaced; if location computed, by taped or EDM traverse; landowner remarks, etc. (Use reverse side if necessary) LOCATION (Indicated by 'X') SEAL: 4/5/2001 - FOUND MONUMENT TO BE 8.39' NORTH AND 0.79' WEST OF SINGLE PROPORTIONATE POSITION, RESEARCH INDICATED ALL SURVEYS IN ADJACENT SECTIONS USED A SINGLE CREGORY P. PROPORTIONATE POSITION IN COMPS. MOUED WHINEHART MONUMENT TO CORRECT LOCATION AND RE-5-1478 MEASURED ALL TIES: SET 3/4" ROD AT OLD LOCATION, DATA SHOWN HERE ON CERTIFIED CORRECT: and Surveyor DATE: TIE SKETCH PHRUE IN DIRT Show at least four ties, also fence lines, roads, topo, size 14" JACK PINE /BT and type of witness trees' and if off road - best way to arrive at corner. 3/4" ROD 8.43 MAINTENANCE RECORD 10" W, DAK Date Init. Remarks 12-16-02 JG OK 1-26-07 36

## ADAMS COUNTY

### Survey Monument Record

TYPE OF MONUMENT: Harrison Monument
STATE PLANE COORDINATES: N\_\_\_\_\_

ELEVATION — M.S.L. DATUM: \_\_\_\_\_

THETA ANGLE:

FIELD BOOK: \_\_\_\_\_\_ PAGE \_\_\_\_\_

#### BASIS FOR MONUMENT LOCATION

(Use reverse side if necessary)


Show info such as: History of corner, with reference to Vol. and pg, dates, surveyor; exact description of monument replaced; if location computed, by taped or EDM traverse; landowner remarks, etc.

Ran EDM/transit traverse around Section 25 and to adjacent section corners to determine search areas for investigation.

Could find no evidence of the original corner or any remonumentation.

Set corner by single proportionate measure between adjacent section corners.

OK 9-12.78 RN-SS 3-14-83 GR-SS OK OK, 7-29-92 JG-BS 1-NEW, 1-22-98-JG

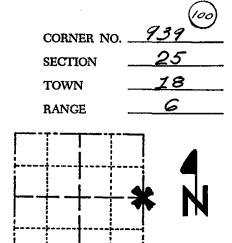

LOCATION
(Indicated by 'X')

SEAL:

DALE C.
HAGEN
S-1103
Wisconsin Rapids,
Wis.

