28 SECTION

06 ADAMS COUNTY COUNTY CORNER NO: 106

ROMPORTOL ID: 41806280020

PUBLIC LAND SURVEY MONUMENT RECORD

HARRISON TYPE OF MONUMENT: ADAMS COUNTY COORDINATES, NAD 83 (2007)

N. **229563.019**

E. 538985.664


ELEVATION-DATUM

FIELD WORK DATE: 07/01/2019


BASIS FOR MONUMENT LOCATION

1974 - PLS 1103 SET HARRISON MONUMENT EQUIDISTANT AND ON LINE BETWEEN ADJACENT SECTION CORNERS. DUG WITH BACKHOE. FOUND NOTHING.

2019 - PLS 2675 FOUND A HARRISON MONUMENT IN THE ROAD SURFACE, 1 PROPERTY IRON AND 1 WITNESS. THE MONUMENT AGREES WITH THE TAPPED DISTANCE TO THE EXISTING WITNESS. ACCEPTED THE HARRISON MONUMENT AS THE CORNER LOCATION. SET 3 NEW TIES AND MEASURED TO THE TIES, PROPERTY IRON AND WITNESS.

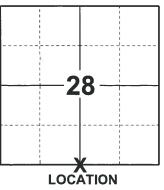

(INDICATE CORNER BY "X")

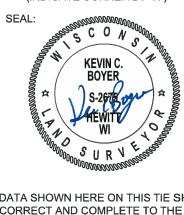

DATA SHOWN HERE ON THIS TIE SHEET IS CORRECT AND COMPLETE TO THE BEST OF MY KNOWLEDGE AND BELIEF.


PROFESSIONAL LAND SURVEYOR

-TIE SKETCH

NOTE: THE CORNER FALLS 3'± SOUTH OF THE CENTERLINE OF CZECH AVE.



- SET 3/4" x 18" IRON REBAR, 1.50#/FT
- FOUND 3/4" IRON ROD
- FOUND HARRISON MONUMENT
- STEEL FENCE POST
- VINYL "T" POST

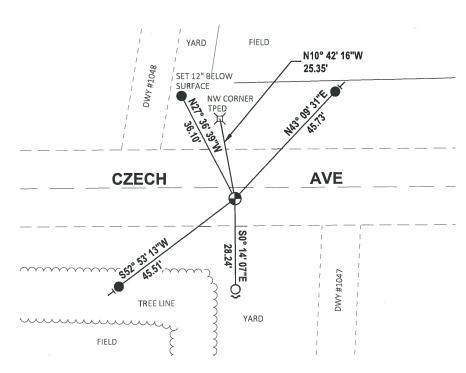

ADAMS COUNTY CORNER NO. SECTION Survey Monument Record TOWN TYPE OF MONUMENT: 30" Harrison standard RANGE STATE PLANE COORDINATES: N_ E_ ELEVATION - M.S.L. DATUM: _ THETA ANGLE: ___ FIELD BOOK: _____ PAGE _ BASIS FOR MONUMENT LOCATION (Use reverse side if necessary) Show info such as: History of corner, with reference to Vol. and pg, dates, surveyor; exact description of monument replaced; if location computed, by taped or EDM traverse; landowner LOCATION (Indicated by 'X') ENERGICAN SIA SEAL: remarks, etc. Set equidistant and on line between adjacent section corners. Dog with back how - Found nothing DALE C. HAGEN S-1103 Wisconsin Rapids, Wis. 7-18-78 PK-SS OK 3-2-83 GR-55 CERTIFIED CORRECT: Z-24-88 GR- SS 7-28-92 JG-BS Registered Land Surveyor, 1-60NE, I-NEW, 1-22-98- JG DATE: _ TIE SKETCH OK, 12-13-02-56 (Show at least four ties) 1-6wE 1-NEW 11-21-07 65 6" Aspentar 26" Blk. Oak BT Pole (Bark scribed) 6020 O4 NW COR TELE PED #2079 Q CZECH AUE. 85.21 6 6" BURK OAK FIELD FIELD