SECTION

D6 ADAMS COUNTY CORNER NO: 108 ROMPORTOL ID: 41806270020

PUBLIC LAND SURVEY MONUMENT RECORD

HARRISON TYPE OF MONUMENT: ADAMS COUNTY COORDINATES, NAD 83 (2007)

N. 229589.698

E. 544275.734

ELEVATION-____ DATUM__

FIELD WORK DATE: 07/01/2019


BASIS FOR MONUMENT LOCATION

1978 - PLS 878 SET EQUIDISTANT AND ON LINE BETWEEN ADJACENT SECTION CORNERS. EXCAVATION OF SEARCH AREA WITH BACKHOE YIELDED NO EVIDENCE OF ANY PREVIOUS MONUMENTATION.

2019 - PLS 2675 FOUND A HARRISON MONUMENT 4" BELOW THE ROAD SHOULDER AND 3 WITNESSES. THE MONUMENT AGREES WITH THE EXISTING WITNESSES. ACCEPTED THE HARRISON MONUMENT AS THE CORNER LOCATION. SET 4 NEW TIES AND MEASURED TO THE TIES AND WITNESSES.



(INDICATE CORNER BY "X")

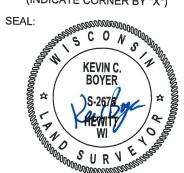

DATA SHOWN HERE ON THIS TIE SHEET IS CORRECT AND COMPLETE TO THE BEST OF MY KNOWLEDGE AND BELIEF.

PROFESSIONAL LAND SURVEYOR

DATE

-TIE SKETCH

NOTE: THE CORNER FALLS 10'± NORTH OF THE CENTERLINE OF CZECH AVE.



MIXED WOODS ST SIDE BUNG. CABLE SIGN N77° 52' 53"W WEST SIDE BURIED **CZECH AVE**

FIELD

- SET 3/4" x 18" IRON REBAR, 1.50#/FT
- FOUND HARRISON MONUMENT
- VINYL "T" POST
- WITNESS TREE

Government Land Corner Certificate


TYPE OF MONUMENT: TEMP. SPIKE STATE PLANE COORDINATES: N ELEVATION — M.S.L. DATUM: THETA ANGLE: FIELD BOOK:57 PAGE 65	ADAMS_County	
ELEVATION — M.S.L. DATUM: THETA ANGLE: FIELD BOOK:57 PAGE 65	TYPE OF MONUMENT: TEMP. SPIKE	
THETA ANGLE: FIELD BOOK: 57 PAGE 65	STATE PLANE COORDINATES: N	
THETA ANGLE: FIELD BOOK: 57 PAGE 65	E	
FIELD BOOK: 57 PAGE 65	ELEVATION — M.S.L. DATUM:	
	THETA ANGLE:	
DRAWN BY: BETTY MERZ	DRAWN BY: BETTY MERZ	

BASIS FOR MONUMENT LOCATION


Show info such as: History of corner, with reference to Vol. and pg., dates, surveyor; exact description of monument replaced; if location computed, by taped or EDM traverse; landowner remarks, etc. (Use reverse side if necessary)

Set equidistant and on line between adjacent section corners.

Excavation of search area with backhoe yeilded no evidence of any previous monumentation.

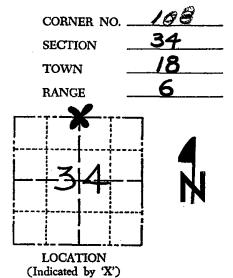

SEAL:

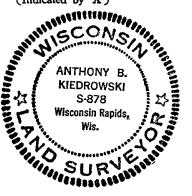


DATA SHOWN HERE ON CERTIFIED CORRECT:

Anthony B. Kuchowshi Registered Land Surveyor

DATE: 8-1-78

TIE SKETCH

Show at least four ties, also fence lines, roads, topo, size and type of witness trees' and if off road - best way to arrive at corner.

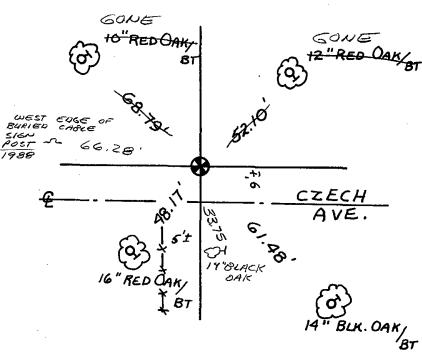

MAINTENANCE RECORD

Date	Init.	Remarks
3.5.83	GR-55	6. K.
3-10-88	GR-SS	2 NEW TIES
7-28-92	JG-BS	6. K.
1-2298	JG	OK
12-13-02	JG	OK
11-21-07	25	OK