26 SECTION

O6 RANGE ADAMS COUNTY CORNER NO: 110 ROMPORTOL ID: 41806260020

PUBLIC LAND SURVEY MONUMENT RECORD

HARRISON (BROKEN-TOP) TYPE OF MONUMENT: ADAMS COUNTY COORDINATES, NAD 83 (2007)

N. 229611.180

E. 549480.427

DATUM

FIELD WORK DATE:___ 06/27/2019


BASIS FOR MONUMENT LOCATION

1972 - PLS 981 SET HARRISON MONUMENT AND TIED OUT CORNER.

2019 - PLS 2675 FOUND A HARRISON MONUMENT WITH A BROKEN-TOP 6" BELOW THE GROUND SURFACE, 2 TIES AND 1 PROPERTY IRON. THE MONUMENT AGREES WITH THE EXISTING TIES. ACCEPTED THE HARRISON MONUMENT WITH A BROKEN-TOP AS THE CORNER LOCATION. SET 3 NEW TIES AND MEASURED TO THE TIES AND PROPERTY IRON.



(INDICATE CORNER BY "X")

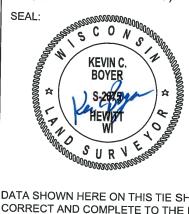

DATA SHOWN HERE ON THIS TIE SHEET IS CORRECT AND COMPLETE TO THE BEST OF MY KNOWLEDGE AND BELIEF.

MIXED WOODS

(LOGGED OFF)


PINE PLANTATION

PROFESSIONAL LAND SURVEYOR

-TIE SKETCH

VINYL "T" POST

NOTE: THE CORNER FALLS 26'± NORTH OF THE CENTERLINE OF CZECH AVE.

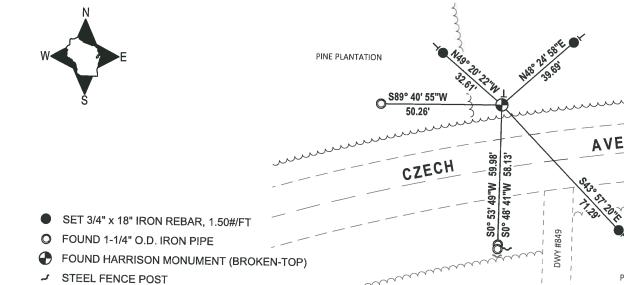

PINE PLANTATION

ADAMS COUNTY

Survey Monument Record

TYPE OF MONUMENT: 30" HARRISON
STATE PLANE COORDINATES: N_____

E____

ELEVATION — M.S.L. DATUM: ___

THETA ANGLE:


FIELD BOOK: PAGE

BASIS FOR MONUMENT LOCATION


(Use reverse side if necessary)

Show info such as: History of corner, with reference to Vol. and pg, dates, surveyor; exact description of monument replaced; if location computed, by taped or EDM traverse; landowner remarks, etc.

Set by Sam Mullen.

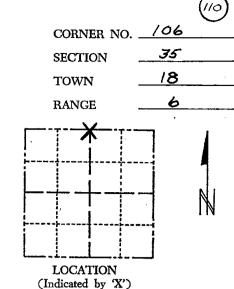

SEAL:

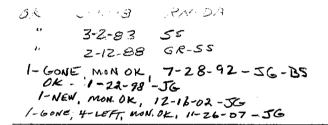

CERTIFIED CORRECT:

Registered Land Surveyor
DATE: 1972

TIE SKETCH

(Show at least four ties)

