18 TOWN

ADAMS COUNTY COUNTY COUNTY CORNER NO: 115

ROMPORTOL ID: 41806312000


PUBLIC LAND SURVEY MONUMENT RECORD

HARRISON TYPE OF MONUMENT:_ ADAMS COUNTY COORDINATES, NAD 83 (2007) N. 226804.500 E. 531096.319 ELEVATION-DATUM 12/18/2019 FIELD WORK DATE:


BASIS FOR MONUMENT LOCATION

1974 - PLS 1103 REPLACED 2" IRON PIPE FOUND BY RETRACEMENT OF ENCHANTED VISTA SUBDIVISION SURVEYED BY R.K. SAYLER. SET HARRISON STANDARD WITH CHUNKS OF SAND STONE PILED AROUND TOP 6". THIS CORNER FALLS ON THE EAST SHOULDER OF FRIENDSHIP MOUND APPROXIMATELY 205' FROM THE TOP AND 55' NORTH OF A UTILITY LINE RUNNING TO THE FIRE TOWER ON THE MOUND.

2019 - PLS 2675 FOUND HARRISON 6" ABOVE THE GROUND AND 2 WITNESS TREES, AND 1 WITNESS STUMP. THE MONUMENT AGREES WITH ALL 3 WITNESSES TREES. ACCEPTED THE HARRISON AS THE CORNER LOCATION. SET 4 NEW TIES AND MEASURED TO THE EXISTING WITNESS TREES.

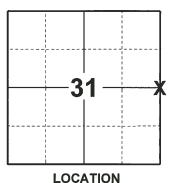


(INDICATE CORNER BY "X")

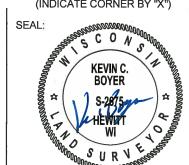

DATA SHOWN HERE ON THIS TIE SHEET IS CORRECT AND COMPLETE TO THE BEST OF MY KNOWLEDGE AND BELIEF.

PROFESSIONAL LAND SURVEYOR

-TIE SKETCH

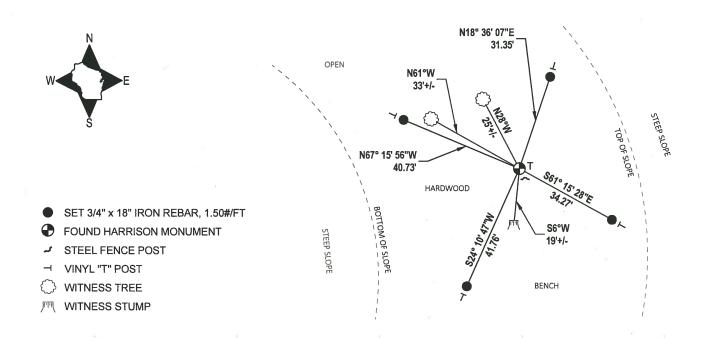

ADAMS COUNTY

Survey Monument Record

ELEVATION — M.S.L. DATUM: _______

THETA ANGLE: _______ PAGE ______

BASIS FOR MONUMENT LOCATION

21020 1 011 11201 1211 121 12001

(Use reverse side if necessary)

Show info such as: History of corner, with reference to Vol. and pg, dates, surveyor; exact description of monument replaced; if location computed, by taped or EDM traverse; landowner remarks, etc.

Replaced 2" Iron Pipe found by retracement of Enchanted Vista Subdivisoin surveyed by R. K. Sayler. Set Harrison Standard with chunks of sand stone piled around top 6".


This corner falls on the East shoulder of Friendship Mound approximately 250 feet from the top and 550 feet North of a utility line running to the fire tower on the mound.

 CORNER NO.
 562

 SECTION
 32

 TOWN
 /8

 RANGE
 6

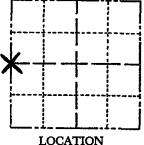

LOCATION (Indicated by 'X')

SEAL:



OK 12-1-78 RN-DA 3.8.83 GR-SS I NEW TIE 1-GONE, 7-29-92 JG-BS OK 4-23-98 JG-SS

1-GONE, 1-NEW, MON.OK 12-10-02 - JG

CERTIFIED CORRECT:

TIE SKETCH Nov 08, STZ

(Show at least four ties)

