06 RANGE ADAMS COUNTY CORNER NO: 119 ROMPORTOL ID: 41806352000

PUBLIC LAND SURVEY MONUMENT RECORD

HARRISON TYPE OF MONUMENT:_ ADAMS COUNTY COORDINATES, NAD 83 (2007) N. 227004.784 E. 552072.589


ELEVATION- - - DATUM

12/12/2019 FIELD WORK DATE:_


BASIS FOR MONUMENT LOCATION

1978 - PLS 878 FOUND EXISTING HARRISON MONUMENT (NO RECORD) WHILE RUNNING EDM TRAVERSE OF SECTION 35, T18N, R6E. THIS MONUMENT "FIT" THE SECTION DIMENSIONS QUITE WELL AND WAS ACCEPTED AS CORRECT.

2019 PLS - 2675 FOUND HARRISON 2" ABOVE THE GROUND AND 2 WITNESS TREES. THE MONUMENT AGREES WITH BOTH WITNESS TREES. ACCEPTED THE HARRISON AS THE CORNER LOCATION. SET 4 NEW TIES AND MEASURED TO THE EXISTING WITNESS TREES.

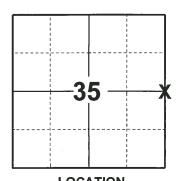

LOCATION (INDICATE CORNER BY "X")

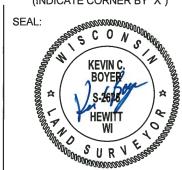

DATA SHOWN HERE ON THIS TIE SHEET IS CORRECT AND COMPLETE TO THE BEST OF MY KNOWLEDGE AND BELIEF.


PROFESSIONAL LAND SURVEYOR

-TIE SKETCH

NOTE: THE CORNER LANDS 27'± WEST OF THE **TRAIL**



- SET 3/4" x 18" IRON REBAR, 1.50#/FT
- FOUND HARRISON MONUMENT
- STEEL FENCE POST
- VINYL "T" POST
- WITNESS TREE

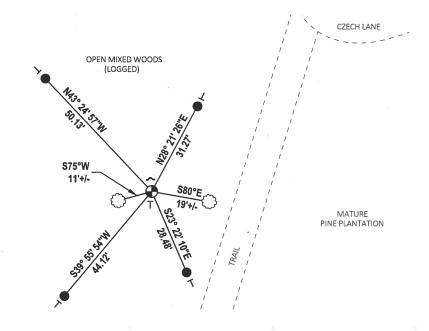

Government Land Corner Certificate

ADAMS	_County
TYPE OF MONUMENT: HARRISON	<u>.</u>
STATE PLANE COORDINATES: N	
<u>E</u>	
ELEVATION — M.S.L. DATUM:	
THETA ANGLE:	
FIELD BOOK:	PAGE
DRAWN BY: Scott SORENSEN	

SECTION TOWN RANGE

CORNER NO. _



BASIS FOR MONUMENT LOCATION

Show info such as: History of corner, with reference to Vol. and pg., dates, surveyor; exact description of monument replaced; if location computed, by taped or EDM traverse; landowner remarks, etc. (Use reverse side if necessary)

Found Existing Harrison Monument(No Record) while running EDM traverse of Section 35, T18N., R6E. This Monument "fit" the section dimensions quite well and was accepted as correct.

ANTHONY B.
KIEDROWSKI
S-878
Wisconsin Rapids,
Wis.

DATA SHOWN HERE ON CERTIFIED CORRECT:

Registered Land Surveyor

EXISTING OZ"IRON

DATE: 13

TIE SKETCH

Show at least four ties, also fence lines, roads, topo, size and type of witness trees' and if off road - best way to arrive at corner.

METAL POST ONDSIGN AT CORNER

SEAL:

8"BLACK OAK/



MAINTENANCE RECORD

THE TENTE TELESTED		
Date	Init.	Remarks
3-10-83	6R-55	O.K
Z-1Z-88	11 11	
7-29-92	JG-BS	OK.
2-2-98	J6	OK
12-16-62	JG	οK
11-26-61	56	OK