36 SECTION 18 TOWN 06 RANGE

# **ADAMS COUNTY**

COUNTY CORNER NO: 133


ROMPORTOL ID: 41806360000

## PUBLIC LAND SURVEY MONUMENT RECORD


#### BASIS FOR MONUMENT LOCATION

1976 - PLS 1053 EXCAVATED AND FOUND THE BOTTOM THIRD OF A STONE MONUMENT. SET A HARRISON MONUMENT AT THE LOCATION THE STONE MONUMENT WAS FOUND AND TIED OUT.

2017 - PLS 2994 FOUND A HARRISON MONUMENT 8" BELOW THE ROAD SURFACE AND 1 PROPERTY IRON. ACCEPTED THE HARRISON MONUMENT AS THE CORNER LOCATION. SET 3 NEW TIES AND MEASURED TO THE TIES.

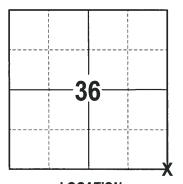

LOCATION (INDICATE CORNER BY "X")

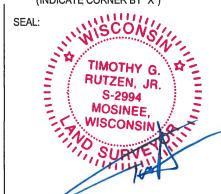

DATA SHOWN HERE ON THIS TIE SHEET IS CORRECT AND COMPLETE TO THE BEST OF MY KNOWLEDGE AND BELIEF.

PROFESSIONAL LAND SURVEYOR

DATE 1-4-18


#### - TIE SKETCH

NOTE: THE CORNER FALLS 3'± NORTH OF THE CENTERLINE OF CTH J.



- 3/4" x 18" IRON REBAR SET, 1.50#/FT
- HARRISON FOUND

  STEEL FENCE POST
- → VINYL "T" POST

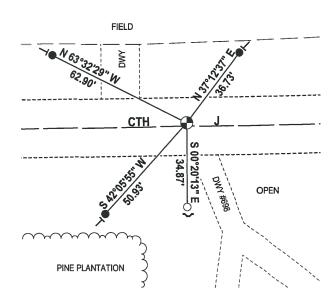

## ADAMS COUNTY

## Survey Monument Record

Harrison TYPE OF MONUMENT: \_

STATE PLANE COORDINATES: N\_

ELEVATION - M.S.L. DATUM: \_\_\_

THETA ANGLE: \_\_

FIELD BOOK: \_\_\_\_

### BASIS FOR MONUMENT LOCATION

(Use reverse side if necessary)

Show info such as: History of corner, with reference to Vol. and pg, dates, surveyor; exact description of monument replaced; if location computed, by taped or EDM traverse; landowner

excavated and found the bottom third of a stone monument

replaced at the location of found monument

OK 9-12-78 RN-SS 3-10-83 GR-55

2 NEW TIES 3-10-88 GR-SS

O.K. 7-28-92, JG-BS


1-GONE, 1-NEW, 2-1-98-56

CORNER NO. 36 SECTION

T 18 N

TOWN RANGE

R 6 E

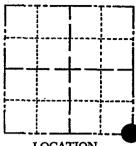

LOCATION (Indicated by 'X')

SEAL:



CERTIFIED CORRECT:

Registered Land Surveyor DATE:

1-NEW, 1-GONE, MON. OK, 12-16-02-JG TIE SKETCH Z-GONE, Z-NEW, MON. OK 11-26-07- JG (Show at least four ties)

NOTE: Ties in trees to

nail in disc.

GONE 07" " Norway Pine GONE Tel. Pole

Centerline C.T.H. J

NW COR AT GROUND TELE PED

6"<del>-Norway</del>

REVISED 1974