## LAND CORNER MONUMENT INDEX


TOWN \_/8\_\_

Corner Monumented
Tie Sheet Filed in Adjoining
Township as Indicated

RANGE \_\_\_\_\_\_

Corner Monumented
Tie Sheet In This Book

Corner May or May Not
Be Monumented -- No Ties

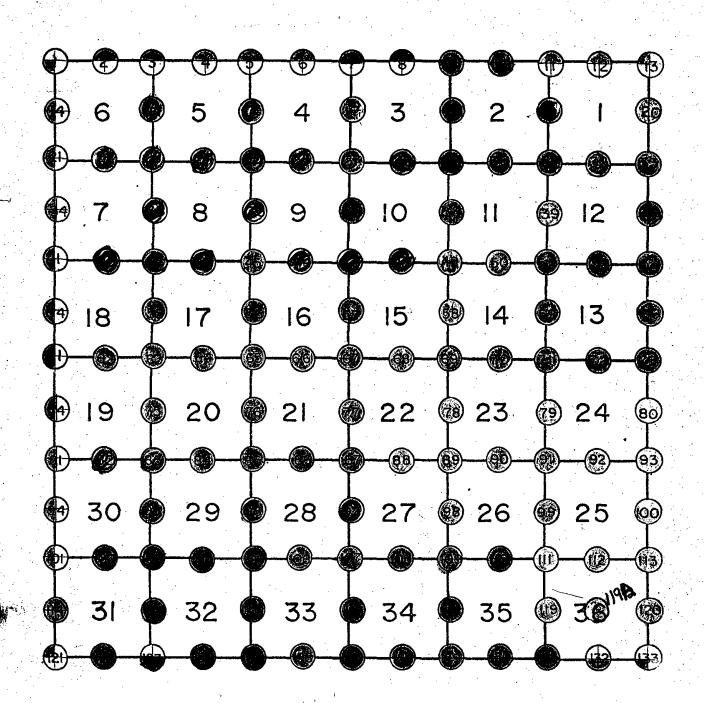

. . \ / Ä 1