OT RANGE ADAMS COUNTY COUNTY CORNER NO: 16 ROMPORTOL ID: 41807052000


PUBLIC LAND SURVEY MONUMENT RECORD

TYPE OF MONUMENT:_	HARRISON	
ADAMS COUNTY COOR	RDINATES, NAD 83 (2007)	
N 25354 0	0.438	
E. 567436	.937	
ELEVATION	DATUM -	
FIELD WORK DATE:	01/08/2020	
	·	


BASIS FOR MONUMENT LOCATION

1983 - PLS 1551 RESET THE CORNER FROM REMAINS OF ORIGINAL NORTHWEST BEARING TREE, THE STUMP OF WHICH WAS FOUND AND REMARKED BY M.C. SMITH IN 1902 (VOL. 1, PG. 22). STUMP IS NOW A MOSS-COVERED HUMMOCK. REMAINS FROM CENTER WERE VERIFIED AS WHITE PINE BY U.S. FOREST LAB IN MADISON. SIZEABLE AREA WAS EXCAVATED FOR STAKE, BUT NOT FOUND, SANDY SOIL CONDITIONS EXIST WITH WATER TABLE AT ABOUT 30". LOCATION OF THIS CORNER AGREES WITH DISTANCES AROUND THE SECTION BY M.C. SMITH WITHIN A FEW

2020 - PLS 2675 FOUND HARRISON FLUSH WITH THE GROUND AND 3 WITNESS TREES, ALSO FOUND A DEPRESSION THAT BEARS N84°W 4'± TO THE APPROXIMATE CENTER FROM HARRISON. THE MONUMENT AGREES WITH ALL 3 WITNESS TREES. ACCEPTED THE HARRISON AS THE CORNER LOCATION. SET 4 NEW TIES AND MEASURED TO THE WITNESS TREES, AND APPROXIMATE CENTER OF DEPRESSION.

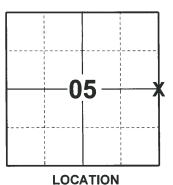

(INDICATE CORNER BY "X")

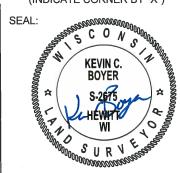


DATA SHOWN HERE ON THIS TIE SHEET IS CORRECT AND COMPLETE TO THE BEST OF MY KNOWLEDGE AND BELIEF.

PROFESSIONAL LAND SURVEYOR 3 9 2020

-TIE SKETCH



- SET 3/4" x 18" IRON REBAR, 1,50#/FT
- FOUND HARRISON MONUMENT
- WITNESS DEPRESSION HOLE
- VINYL "T" POST
- WITNESS TREE

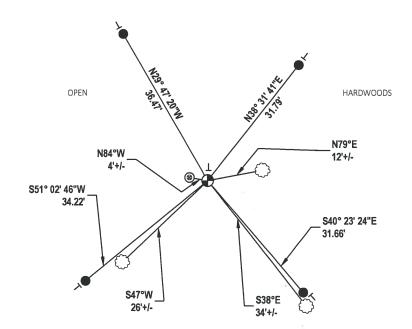

U.S. PUBLIC LAND SURVEY MONUMENT RECORD

<u>ADAMS COUNTY</u>
TYPE OF MONUMENT: Standard Harrison
STATE PLANE COORDINATES: N
F
ELEVATION M.S.L. DATUM:
THETA ANGLE:
FIELD BOOK: Adams County PAGE 40
DRAWN BY: D. Riesop

BASIS FOR MONUMENT LOCATION

Show info such as: History of corner, with reference to Vol. and pg., dates, surveyor; exact description of monument replaced; if location computed, by taped or EDM traverse; landowner remarks, etc. (Use reverse side if necessary) (in conformance with Section A-E 502 of the Wisconsin Administrative Code)

Corner was reset from remains of original Northwest bearing tree, the stump of which was found and remarked by M. C. Smith in 1902 (vol. 1, page 22)

Stump is now a moss-covered hummock. Remains from center were verified as White Pine by U.S. Forest Lab in Madison.

Sizeable area was excavated for stake, but not found, sandy soil conditions exist with water table at about 30".

Location of this corner agrees with distances around the section by M.C. Smith within a few feet.

LOCATION (Indicated by 'X')

SEAL:



DATA SHOWN HERE ON CERTIFIED CORRECT:

Registered Land Surveyor


DATE: 5/23/83

TIE SKETCH

Show at least four ties, also fence lines, roads, topo, size and type of witness trees' and if off road - best way to arrive at corner.

MAINTENANCE RECORD

Date	Init.	Remarks	
12-4-87	سخدى	OK	
6-8-92	IGBS	OK	_
12-31-97	55	OK	
1-22-02	56	OK	
92-27-07	35	OK .	

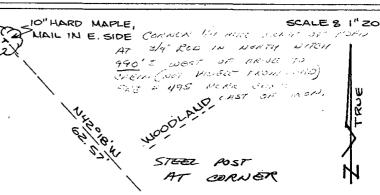

IB" HUMMOCK FROM
ORIGINAL & SUBSEQUENT
B.T., REMNANTS FROM
CENTER VERIFIED BY
U.S. FOREST LAB AS
W. PINE. NOHOW.
3.96

S"HARD MAPLE,
MAIL IN N. SIDE

S"HARD MAPLE,
MAIL IN N. SIDE

S"HARD MAPLE,
MAIL IN N. SIDE

•

.

Section 1985