# ADAMS COUNTY COUNTY CORNER NO: 19 ROMPORTOL ID: 418070222000

PUBLIC LAND SURVEY MONUMENT RECORD

**RAIL ROAD SPIKE** TYPE OF MONUMENT:

ADAMS COUNTY COORDINATES, NAD 83 (2007)

N. **253596.921** 

F 583361.439


DATUM FI FVATION-

01/03/2020 FIELD WORK DATE:


## BASIS FOR MONUMENT LOCATION

1983 - PLS 1551 CORNER AREA WAS EXCAVATED AND ROUND DISCOLORED AREA (APPROX. 3" DIA.) WITH DECAYED WOOD IN THE CENTER WAS FOUND EXTENDING STRAIGHT UP AND DOWN FROM 5" BELOW THE ORIGINAL GROUND SURFACE TO A DEPTH OF 2' FROM SAME. THIS SPOT WAS ACCEPTED AS CORRECT AND MONUMENTED WITH A HARRISON. THE LOCATION OF THIS CORNER IS ON THE EXTENSION OF A VERY OLD FENCE LINE TO THE EAST, WITHIN 1.1' OF THE ORIGINAL DISTANCE FROM THE SOUTH, AGREES WITH REMNANTS OF FENCE WIRE FOUND 1320' NORTH, AND 3' WEST OF THE CENTERLINE OF PAVEMENT. IT IS ALSO WITHIN 00°01' OF A STRAIGHT LINE BETWEEN SECTION CORNERS. THIS LOCATION IS 1' WEST OF AN APPARENT EARLIER EXCAVATION FOR THE CORNER.

2020 - PLS 2675 FOUND RAIL ROAD SPIKE 12"± BELOW THE ROAD SURFACE AND 4 WITNESS TREES. REMOVED THE RAIL ROAD SPIKE AND FOUND NO EVIDANCE OF A HARRISON BELOW. THE RAIL ROAD SPIKE LOCATION AGREES WITH ALL 4 WITNESS TREES. ACCEPTED THE RAIL ROAD SPIKE LOCATION FOR THE CORNER LOCATION. RE-SET RAIL ROAD SPIKE IN ITS LOCATION. SET 4 NEW TIES AND MEASURED TO THE EXISTING WITNESS TREES.

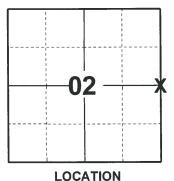

(INDICATE CORNER BY "X")

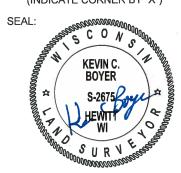

DATA SHOWN HERE ON THIS TIE SHEET IS CORRECT AND COMPLETE TO THE BEST OF MY KNOWLEDGE AND BELIEF.


PROFESSIONAL LAND SURVEYOR 7020

## -TIE SKETCH

NOTE: THE CORNER LANDS 0.7'± EAST OF CTH G CENTERLINE.



- SET 3/4" x 18" IRON REBAR, 1.50#/FT
- FOUND RAIL ROAD SPIKE
- VINYL "T" POST
- WITNESS TREE
  - **IRRIGATION WHEEL STOP**

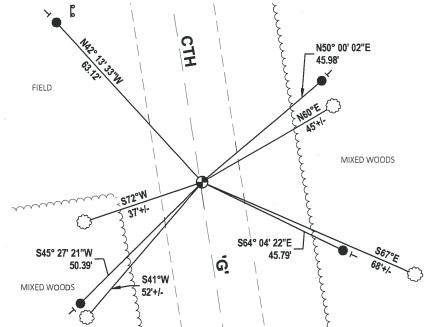


# U.S. PUBLIC LAND SURVEY MONUMENT RECORD

# ADAMS COUNTY TYPE OF MONUMENT: Standard Harrison STATE PLANE COORDINATES: ELEVATION - M.S.L. DATUM: \_\_\_ THETA ANGLE: 19 FIELD BOOK: \_\_ \_ PAGE \_ DRAWN BY: \_D. Riesop

# 2 SECTION 18N TOWN 7E RANGE

CORNER NO. .

19

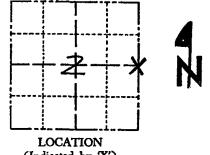

# BASIS FOR MONUMENT LOCATION


Show info such as: History of corner, with reference to Vol. and pg., dates, surveyor; exact description of monument replaced; if location computed, by taped or EDM traverse; landowner remarks, etc. (Use reverse side if necessary) (in conformance with Section A-E 502 of the Wisconsin Administrative Code )

Corner area was excavated and round discolored area (approx. 3" dia.) with decayed wood in the center was found extending straight up and down from 5" belows the original ground surface to a depth of 2' from same. This spot was accepted as correct and monumented.

The location of this corner is on the extension of a very old fence line to the East, within 1.1' of the original distance from the South, agrees with remenants of fence wire found 1320' North, and 3' West of the centerline of pavement. It is also within 00°01' of a straight line between section

This location is 1' West of an apparent earlier excavation for the corner.

SEAL:

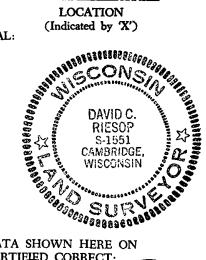

DATA SHOWN HERE ON CERTIFIED CORRECT:

Registered Land Surveyor

///z/83 DATE: \_

### TIE SKETCH

Show at least four ties, also fence lines, roads, topo, size and type of witness trees' and if off road - best way to arrive at corner.

1"=30"

#### MAINTENANCE RECORD

Date	Init.	Remarks	
4-6-87	GR-55	01	
11-26-91	KZ-55	11	
2-18-97	JG-55	OK	
1-24-02	J6-J5	OK	
4-11-07	36	OK	

