ADAMS COUNTY COUNTY CORNER NO: 22 ROMPORTOL ID: 41807060020

PUBLIC LAND SURVEY MONUMENT RECORD

HARRISON (BROKEN-TOP) TYPE OF MONUMENT:

ADAMS COUNTY COORDINATES, NAD 83 (2007)

N. 250904.139

E. 559498.116


ELEVATION-DATUM

05/16/2019 FIELD WORK DATE:


BASIS FOR MONUMENT LOCATION

1983 - PLS 1551 SEARCHED AREA FOR STAKE AND WITNESS TREES, NOTHING WAS FOUND, CORNER WAS RE-ESTABLISHED ON A STRAIGHT LINE BETWEEN SECTION CORNERS AT A PRORATED E-W POSITION. THIS LOCATION FALLS ON STRANDS OF AN OLD N-S FENCE AND AGREES WITH THE DISTANCE NORTH TO THE COMPUTED CENTER OF SECTION.

2019 - PLS 2675 FOUND HARRISON (BROKEN-TOP) 6" BELOW THE GROUND SURFACE AND 4 WITNESSES. THE MONUMENT AGREES WITH ALL 4 WITNESSES. ACCEPTED THE HARRISON (BROKEN-TOP) AS THE CORNER LOCATION. SET 4 NEW TIES AND MEASURED TO THE EXISTING WITNESSES.

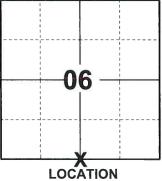

(INDICATE CORNER BY "X")

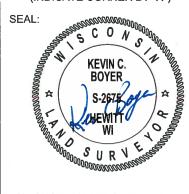

DATA SHOWN HERE ON THIS TIE SHEET IS CORRECT AND COMPLETE TO THE BEST OF MY KNOWLEDGE AND BELIEF.

PROFESSIONAL LAND SURVEYOR

DATE


- TIE SKETCH



- SET 3/4" x 18" IRON REBAR, 0.50#/FT
- FOUND 3/4" IRON PIPE
- FOUND HARRISON (BROKEN-TOP) MONUMENT

MITNESS STUMP

- VINYL "T" POST
- WITNESS TREE

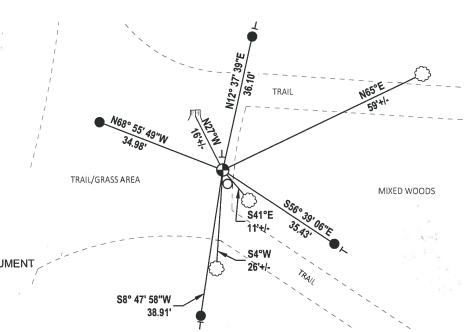

U.S. PUBLIC LAND SURVEY MONUMENT RECORD CORNER NO. 22 ADAMS COUNTY SECTION TYPE OF MONUMENT: ___Standard Harrison 18N TOWN STATE PLANE COORDINATES: RANGE 7E ELEVATION — M.S.L. DATUM: _ THETA ANGLE: . FIELD BOOK: Adams County PAGE 43 DRAWN BY: D. Rieson BASIS FOR MONUMENT LOCATION Show info such as: History of corner, with reference to Vol. and pg., dates, surveyor; exact description of monument replaced; if location computed, by taped or EDM traverse; landowner remarks, etc. (Use reverse side if necessary) (in conformance with Section A-E 502 of the LOCÁTION (Indicated by 'X') SEAL: Wisconsin Administrative Code) HINING CONSTITUTE Searched area for stake and witness trees, nothing was found. DAVID C Corner was re-established on a straight line between RIESOP Section corners at a prorated E-W position. S-1551 CAMBRIDGE. This location falls on strands of an old N-S fence and agrees with the distance North to the computed center of Section. DATA SHOWN HERE ON filed for record this. CERTIFIED_CORRECT: per 59.60 Wisconsin/Statu Registered Land Surveyor 5/26/83 DATE: . ADAMS COUNTY SURVEYOR COTTONVILLE 8" RED OAK MUE TIE SKETCH NAIL-IN-E.-SIDE B.E.C. NEW -087 Show at least four ties, also fence lines, roads, topo, size 5" JACK 3/5/1 197 100190 and type of witness trees' and if off road - best way to PINE arrive at corner. 8" RED OAK, NAIL IN E. SIDE, WIRE IN BASE OF ROAD TREE - NET NAIL 1/2 WEST OF MON. 141 535⁰47 'E ALI ILIGIF 10.76 6" RED OAK WITH SIGN, NAIL IN E. SIDE SCALE 81"=20 MAINTENANCE RECORD TRAIL Remarks Date Init. 1-37 / NEW TIE 5-13-92 **I**6 ALL OK ALL WIN RED OAK 12 OK 1-22-02 " 12" RED OAK, NAIL 26,18 OK IN E.SIDE

M5

2 NEW TIES