06 SECTION

## ADAMS COUNTY COUNTY CORNER NO: 23 ROMPORTOL ID: 41807060000

## PUBLIC LAND SURVEY MONUMENT RECORD

TYPE OF MONUMENT:

**HARRISON** 

ADAMS COUNTY COORDINATES, NAD 83 (2007)

N. 250953.365

E. 562146.136

**ELEVATION-**

DATUM - — —


FIELD WORK DATE:

05/16/2019


## BASIS FOR MONUMENT LOCATION

1983 - PLS 1551 CORNER WAS RESET FROM WHITE OAK BEARING TREE MARKED BY M.C. SMITH IN 1902 SURVEY OF SECTION 5 (VOL. 1. PG. 22) TREE WAS FOUND TO BE HOLLOW BY INCREMENT BORING, BUT CORE RETRIEVED WOULD PRORATE TREES AGE TO CORRECT SIZE AT TIME OF SURVEY. CORNER LOCATION FITS OCCUPATION OF OLD DITCH, AND IS WITHIN 0.6' OF SMITH'S DISTANCE TO THE NORTHWEST CORNER OF THE SECTION.

2019 - PLS 2675 FOUND HARRISON 2" ABOVE THE GROUND SURFACE AND 5 WITNESSES. THE MONUMENT AGREES WITH ALL 5 WITNESSES. ACCEPTED THE HARRISON AS THE CORNER LOCATION. SET 4 NEW TIES AND MEASURED TO THE EXISTING WITNESSES.

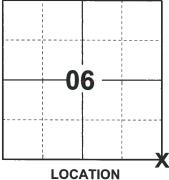


(INDICATE CORNER BY "X")

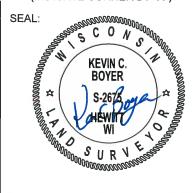

DATA SHOWN HERE ON THIS TIE SHEET IS CORRECT AND COMPLETE TO THE BEST OF MY KNOWLEDGE AND BELIEF.

PROFESSIONAL LAND SURVEYOR

- TIE SKETCH

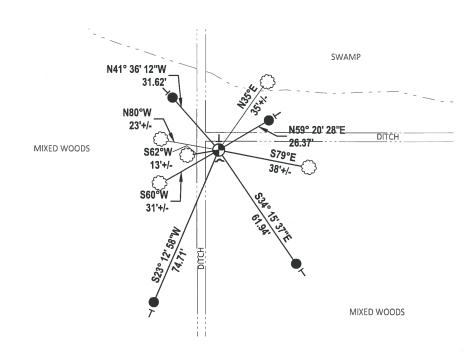

- SET 3/4" x 18" IRON REBAR, 0.50#/FT
- FOUND HARRISON MONUMENT
- STEEL FENCE POST
- VINYL "T" POST
- WITNESS TREE

## U.S. PUBLIC LAND SURVEY MONUMENT RECORD 23 CORNER NO. ADAMS COUNTY SECTION TYPE OF MONUMENT: <u>Standard Harrison</u> 18N. **TOWN** STATE PLANE COORDINATES: 7E. RANGE ELEVATION - M.S.L. DATUM: \_ THETA ANGLE: FIELD BOOK: Adams County 39 DRAWN BY: \_ D. Riesop BASIS FOR MONUMENT LOCATION Show info such as: History of corner, with reference to Vol. and pg., dates, surveyor; exact description of monument replaced; if location computed, by taped or EDM traverse; landowner remarks, etc. (Use reverse side if necessary) (in conformance with Section A-E 502 of the LOCATION SHIP WALL TO WALL THE STATE OF SEAL: Wisconsin Administrative Code ) Corner was reset from White Oak bearing tree marked by M. C. Smith in 1902 survey of Section 5. (Vol. 1,P.22) Tree was found to be hollow by increment boring, RIESOP but core retrieved would prorate trees age to correct size at time of survey. CAMBRIDGE Corner location fits occupation of old ditch, and is within 0.6' of Smith's distance to the Northwest corner of the section. DATA SHOWN HERE ON filed for record this CERTIFIED CORRECT: per 59,60 Wisconsin Statut Registered Land Surveyor 5/23/83 DATE: ADAMS COUNTY SURVEYOR 15"JACK TIE SKETCH PINE, NAIL IN W. SIDE Show at least four ties, also fence lines, roads, topo, size and type of witness trees' and if off road - best way to arrive at corner. 10" RED OAK NAIL IN S. SIDE SCALE 8 1"= 20 MAINTENANCE RECORD POST 4" RED OAK, AT CORNER NAIL IN S. SIDE Date Init. Remarks 15" J. PINE. 10-1-87 55 ORI NAIL IN N. SIDE 12/31/97 *I*6 O.K. DND SIGN 0.K. 1-21-02 *3*6 FACING NORT ZZ" W.OAK ON HOGBACK SMITH'S

B.T. IN 1902

10-19-67

2-23-12

36

MS

ALL OK