ADAMS COUNTY COUNTY CORNER NO: 24 ROMPORTOL ID: 41807050020


PUBLIC LAND SURVEY MONUMENT RECORD

TYPE OF MONUMENT:	2-3/8" O.D. IRON PIPE
ADAMS COUNTY COORDINA	ATES, NAD 83 (2007)
N. 250924.43	3
E. <u>564768.716</u>	
ELEVATION	DATUM
FIELD WORK DATE: 01/	06/2020

BASIS FOR MONUMENT LOCATION

1983 - PLS 1551 PROBED AREA FOR STAKE, NOTHING WAS FOUND, EVIDENCE OF ORIGINAL AND SUBSEQUENT WITNESS TREES ARE GONE. CORNER WAS RESET PROPORTIONALLY ON A STRAIGHT LINE BETWEEN SECTION CORNERS. EAST-WEST LOCATION MATCHES SMITH'S IN 1902 WITHIN 0.2 FEET. (VOL. 1, PG. 22)

2020 - PLS 2675 FOUND 2-3/8" O.D. IRON PIPE 12"± ABOVE THE SWAMP AND 4 WITNESS TREES. THE MONUMENT AGREES WITH ALL 4 WITNESS TREES. ACCEPTED THE 2-3/8" O.D. IRON PIPE AS THE CORNER LOCATION. SET 4 NEW TIES AND MEASURED TO THE EXISTING WITNESS TREES.

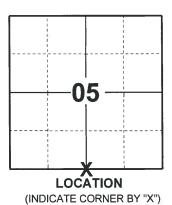


SEAL: SURV

DATA SHOWN HERE ON THIS TIE SHEET IS CORRECT AND COMPLETE TO THE BEST OF MY KNOWLEDGE AND BELIEF.

PROFESSIONAL LAND SURVEYOR

-TIE SKETCH

WITNESS TREE

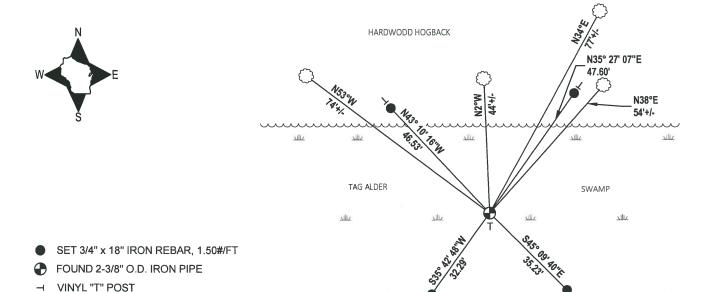

U.S. PUBLIC LAND SURVEY MONUMENT RECORD 24 CORNER NO. _ ADAMS COUNTY 5 SECTION TYPE OF MONUMENT: 2" I.D. x 60" galvanized pipe 18N TOWN STATE PLANE COORDINATES: N. 7E RANGE ELEVATION - M.S.L. DATUM: _ THETA ANGLE: 40 FIELD BOOK: Adams County DRAWN BY: D. Riesop BASIS FOR MONUMENT LOCATION Show info such as: History of corner, with reference to Vol. and pg., dates, surveyor; exact description of monument replaced; if location computed, by taped or EDM traverse; landowner remarks, etc. (Use reverse side if necessary) (in conformance with Section A-E 502 of the LOCATION (Indicated by 'X') SEAL: HINDSON SANGE Wisconsin Administrative Code) Probed area for stake, nothing found. Evidence of original and subsequent witness trees is gone. DAVID C. RIESOP Corner was reset proportionally on a straight line S-1551 CAMBRIDGE between section corners. East - West location matches Smith's in 1902 within 0.2 feet. (Vol. 1, P.22) DATA SHOWN HERE ON filed for record this CERTIFIED CORRECT: day of ... per 59.60 Registered Land Surveyor DATE: ____ 6/1/83 ADAMS COUNTY SURVEYOR HOGBACK RIDGE 8"RED OAK, TIE SKETCH 8" WHITE OAK, NAILIN W. SIDE NAIL IN E. SIDE Show at least four ties, also fence lines, roads, topo, size and type of witness trees' and if off road - best way to arrive at corner. OF MARSH 14" BLK OAK . 97 BIEUMED PLATFORM SCALE 8 1"=50" MARSH MAINTENANCE RECORD 010 Remarks Date Init. 12-31-97 18-35 ADD 2 TIES -22-02 JG 0K DND SIGN 02-21-07 55 ON WHOD POST STUCK IN PIPE 02-23-12 m5 MON OK 15"RED OAK, MAIL JIN W. 3"TAMARACK MAIL IN S. SIDE SIDE

100BACK

