

## PUBLIC LAND SURVEY MONUMENT RECORD

TYPE OF MONUMENT: 2-3/8" O.D. IRON PIPE  
ADAMS COUNTY COORDINATES, NAD 83 (2007)

N. 250881.451

E. 570059.686


ELEVATION:      DATUM     

FIELD WORK DATE: 01/06/2020

### BASIS FOR MONUMENT LOCATION

1983 - PLS 1551 PROBED AREA FOR STAKE AND EVIDENCE OF WITNESS TREES, NOTHING WAS FOUND. 2" X 60" IRON PIPE WAS RESET AT PROPORTIONALLY ON A STRAIGHT LINE BETWEEN SECTION CORNERS.

2020 PLS 2675 - FOUND 2-3/8" O.D. IRON PIPE 12"± ABOVE THE WATER LEVEL AND 4 WITNESS TREES. THE MONUMENT AGREES WITH ALL 4 WITNESS TREES. ACCEPTED THE 2-3/8" O.D. IRON PIPE AS THE CORNER LOCATION. SET 4 NEW TIES AND MEASURED TO THE WITNESS TREES.

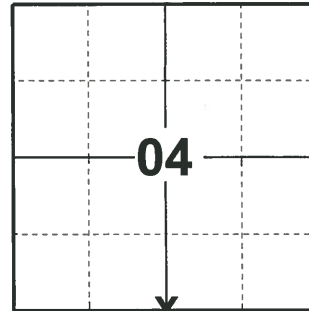

LOCATION

(INDICATE CORNER BY "X")

SEAL:





DATA SHOWN HERE ON THIS TIE SHEET IS CORRECT AND COMPLETE TO THE BEST OF MY KNOWLEDGE AND BELIEF.

PROFESSIONAL LAND SURVEYOR

DATE 3/9/2020

### - TIE SKETCH

NOTE: THE CORNER LANDS 34± EAST OF TRAIL

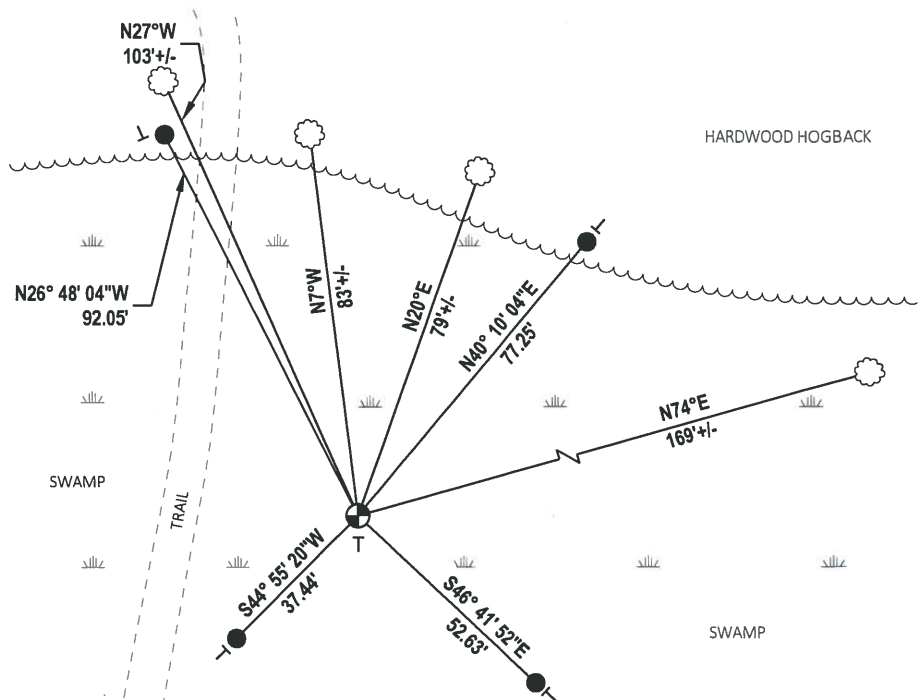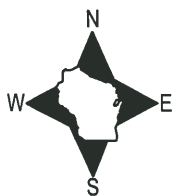

- SET 3/4" x 18" IRON REBAR, 1.50#/FT
- ⊕ FOUND 2-3/8" O.D. IRON PIPE
- ⊢ VINYL "T" POST
- ☼ WITNESS TREE

# U.S. PUBLIC LAND SURVEY MONUMENT RECORD

## ADAMS COUNTY

TYPE OF MONUMENT: 2" I.D. x 60" galvanized pipe

STATE PLANE COORDINATES: N \_\_\_\_\_  
E \_\_\_\_\_

ELEVATION — M.S.L. DATUM: \_\_\_\_\_

THETA ANGLE: \_\_\_\_\_

FIELD BOOK: Adams County PAGE 42


DRAWN BY: D. Riesop

CORNER NO. 26

SECTION 4

TOWN 18N

RANGE 7E

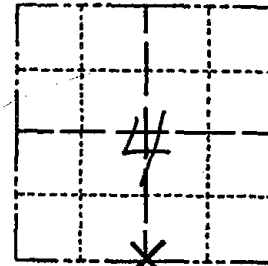

LOCATION  
(Indicated by 'X')




### BASIS FOR MONUMENT LOCATION

Show info such as: History of corner, with reference to Vol. and pg., dates, surveyor; exact description of monument replaced; if location computed, by taped or EDM traverse; landowner remarks, etc. (Use reverse side if necessary) (in conformance with Section A-E 502 of the Wisconsin Administrative Code)

Probed area for stake and evidence of witness trees, nothing was found.

Corner was reset proportionally on a straight line between Section corners.

SEAL:

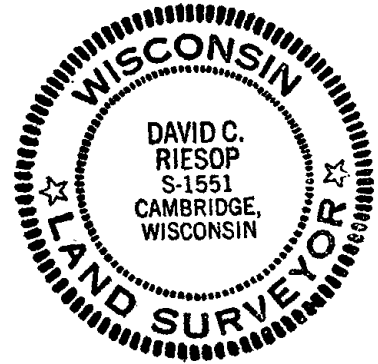

DATA SHOWN HERE ON  
CERTIFIED CORRECT:


David C. Riesop  
Registered Land Surveyor

DATE: 5/27/83

filed for record this OK .....  
day of JUNE ..... 19 83  
per 59.60 Wisconsin Statutes.  
D. Riesop  
ADAMS COUNTY SURVEYOR

### TIE SKETCH

Show at least four ties, also fence lines, roads, topo, size and type of witness trees and if off road - best way to arrive at corner.

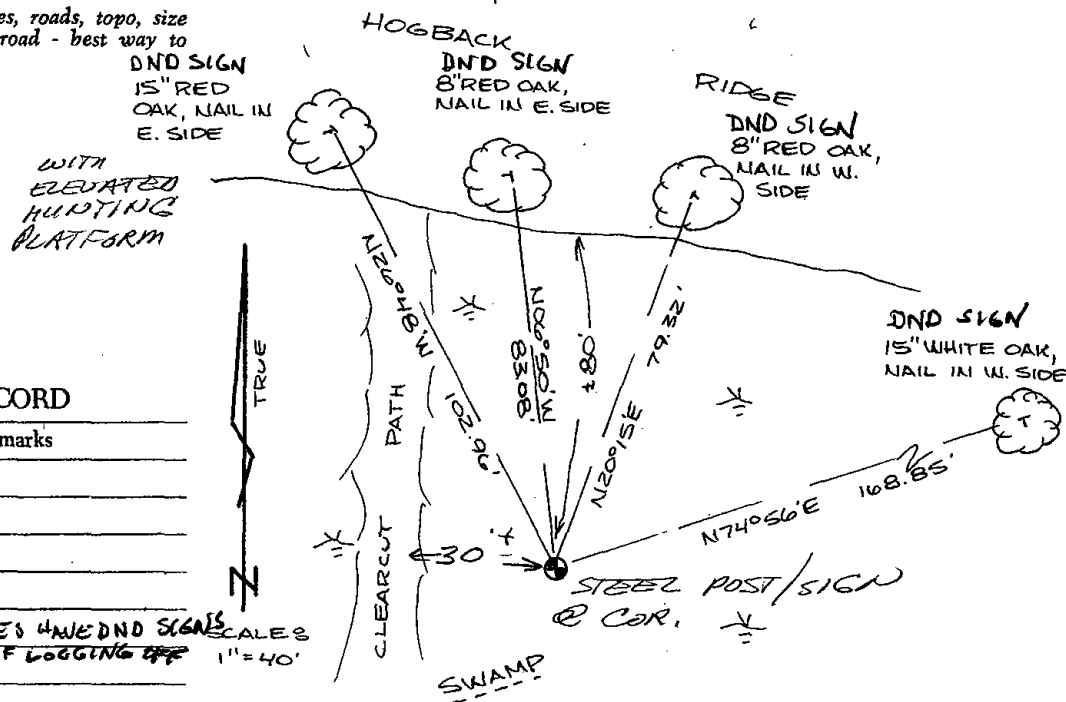

### MAINTENANCE RECORD

Date	Init.	Remarks
3-9-81	GR	OK
1-5-92	SG-BS	OK
12-31-97	JG-SS	OK
1-18-02	GR-SG	OK
2-21-07	JG	OK ALL TREES 4 WEDND SIGNS BECAUSE OF LOGGING

SCALE 1" = 40'

