ADAMS COUNTY COUNTY CORNER NO: 27 ROMPORTOL ID: 41807040000

PUBLIC LAND SURVEY MONUMENT RECORD

HARRISON TYPE OF MONUMENT: ADAMS COUNTY COORDINATES, NAD 83 (2007)

N. 250867.664

E. 572728.656

ELEVATION- _ - _ DATUM_

FIELD WORK DATE: 01/06/2020


BASIS FOR MONUMENT LOCATION

1983 - PLS 1551 HARRISON WAS RESET FROM CHARRED REMAINS OF ORIGINAL NORTHEAST BEARING TREE. (18" PINE IN 1852) THIS LOCATION AGREES WITH REMAINS OF OLD FENCE LINE TO NORTH AND EAST OF CORNER, AND CHECKS WITH PRORATED DISTANCES FROM ORIGINAL SURVEY.

2020 - PLS 2675 FOUND HARRISON FLUSH WITH THE GROUND AND 4 WITNESS TREES. THE MONUMENT AGREES WITH ALL 4 WITNESS TREES. ACCEPTED THE HARRISON AS THE CORNER LOCATION. SET 4 NEW TIES AND MEASURED TO THE EXISTING WITNESS TREES.



(INDICATE CORNER BY "X")

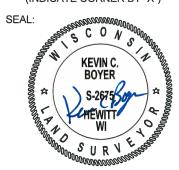

DATA SHOWN HERE ON THIS TIE SHEET IS CORRECT AND COMPLETE TO THE BEST OF MY KNOWLEDGE AND BELIEF.

PROFESSIONAL LAND SURVEYOR

2020

-TIE SKETCH

NOTE: WITNESS TREE IS S0°E, 1'±.



LOGGED OFF MIXED WOODS N65°W 8'+/-OPEN MIXED WOODS S28°E S7°E 22'+/-20'+/-

- SET 3/4" x 18" IRON REBAR, 1.50#/FT
- FOUND HARRISON MONUMENT
- VINYL "T" POST
- WITNESS TREE

U.S. PUBLIC LAND SURVEY MONUMENT RECORD

<u>ADAMS COUNTY</u>	
TYPE OF MONUMENT: Standard Harrison	•.
STATE PLANE COORDINATES: N	
· E	_
ELEVATION — M.S.L. DATUM:	
THETA ANGLE:	_
FIELD BOOK:Adams County PAGE41	-
DRAWN BY: D. Riesop	_

BASIS FOR MONUMENT LOCATION

Show info such as: History of corner, with reference to Vol. and pg., dates, surveyor; exact description of monument replaced; if location computed, by taped or EDM traverse; landowner remarks, etc. (Use reverse side if necessary) (in conformance with Section A-E 502 of the Wisconsin Administrative Code)

Corner below was reset from charred remains of original Northeast bearing tree. (18" Pine in 1852)

This location agrees with remains of old fence line to North and East of corner, and checks with prorated distances from original survey

filed for record this day of . per 59.60 Wisconsin, Statute ADAMS COUNTY SURVEYOR

TIE SKETCH

Show at least four ties, also fence lines, roads, topo, size and type of witness trees' and if off road - best way to arrive at corner.

MAINTENANCE RECORD

WINITIENATIVE RECORD		
Date	Init.	Remarks
3-9-87	86	ON
6-5-92	IG-BS	OK
12/31/97	JG-55	OK
2-21-09	J6-55	3-NEW TIES
,		

NW C 27 CORNER NO. SECTION 18N. TOWN 7E. RANGE

LOCATION (Indicated by 'X')


SEAL:



DATA SHOWN HERE ON CERTIFIED_CORRECT:

Registered Land Surveyor

5/23/83 DATE:

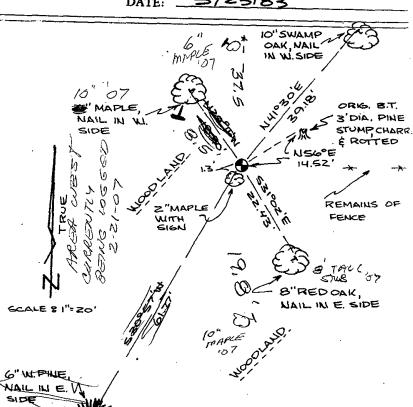

U.S. PUBLIC LAND SURVEY MONUMENT RECORD 27 CORNER NO. ADAMS COUNTY SECTION TYPE OF MONUMENT: Standard Harrison 18N. **TOWN** STATE PLANE COORDINATES: 7E RANGE ELEVATION - M.S.L. DATUM: THETA ANGLE: _ FIELD BOOK: Adams County PAGE 41 DRAWN BY: ___D. Riesop BASIS FOR MONUMENT LOCATION Show info such as: History of corner, with reference to Vol. and pg., dates, surveyor; exact description of monument replaced; if location computed, by taped or EDM traverse; landowner remarks, etc. (Use reverse side if necessary) (in conformance with Section A-E 502 of the LOCATION (Indicated by 'X') SEAL: SHIRING CONSTANT Wisconsin Administrative Code) Corner below was reset from charred remains of original Northeast bearing tree. (18" Pine in 1852) DAVID C This location agrees with remains of old fence **RIESOP** line to North and East of corner, and checks with S-1551 prorated distances from original survey CAMBRIDGE. WISCONSIN DATA SHOWN HERE ON filed for record this CERTIFIED_CORRECT: Registered Land Surveyor per 59.60 Wisconsin, Statutes DATE: _5/23/83 ADAMS COUNTY SURVEYOR 10"SWAMP TIE SKETCH OAK, NAIL IN W.SIPE Show at least four ties, also fence lines, roads, topo, size and type of witness trees' and if off road - best way to ORIG. B.T. 6" MAPLE 3 DIA, PINE W MI JIAM STUMP CHARRED SIDE REMAINS OF FENCE MAINTENANCE RECORD Date Init. Remarks 8"RED OAK, 3-9-81 NAIL IN E. SIDE SCALE 8 1"= 20" 5-92 IG-BS

6" W.PINE, NAIL IN E. SIDE

