03 SECTION

ADAMS COUNTY COUNTY CORNER NO: 28 ROMPORTOL ID: 41807030020


PUBLIC LAND SURVEY MONUMENT RECORD

TYPE OF MONUMENT:	TIARRISON (BROKEN-TOF)
ADAMS COUNTY COORDINATES, NAD 83 (2007)	
N. 250910.018	_
E. 575382.848	_
ELEVATION	DATUM — —
EIELD WORK DATE: 01/15/	12020

BASIS FOR MONUMENT LOCATION

1983 - PLS 1551 FOUND 3" DIAMETER ROTTED WOOD STAKE WHILE DIGGING. STAKE IS 4' NORTH OF A STRAIGHT LINE AND WITHIN 0.3' OF A SPLIT BETWEEN ADJACENT SECTION CORNERS. STAKE WAS REMOVED AND HARRISON MONUMENT WAS SET. ORIGINAL BEARING TREES AND THOSE MARKED IN 1902 (VOL. 3, PG. 29, ADAMS CO. FIELD NOTES) ARE GONE. RETIED OUT.

2020 - PLS 2675 FOUND HARRISON (BROKEN-TOP) 18"± BELOW THE GROUND AND 2 TIES. THE MONUMENT AGREES WITH BOTH TIES. ACCEPTED THE HARRISON (BROKEN-TOP) AS THE CORNER LOCATION. SET 3 NEW TIES AND MEASURED TO THE EXISTING TIES.

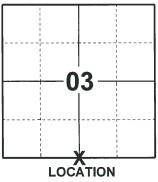

(INDICATE CORNER BY "X")




DATA SHOWN HERE ON THIS TIE SHEET IS CORRECT AND COMPLETE TO THE BEST OF MY KNOWLEDGE AND BELIEF.

PROFESSIONAL LAND SURVEYOR

2020

-TIE SKETCH

NOTE: THE CORNER LANDS 7'± OFF THE CENTERLINE OF TRAIL AND 47.4'± SE OF COTTONVILLE AVE/3RD DR CENTERLINE.

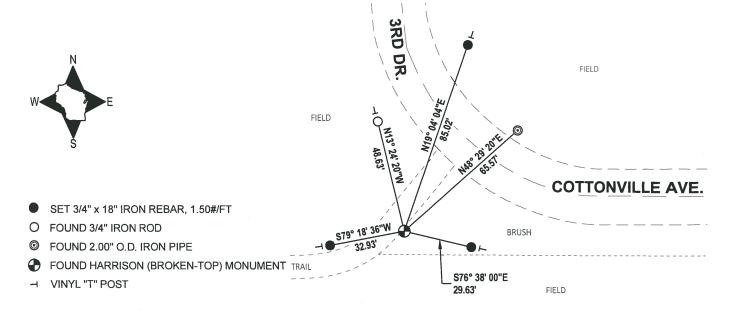

U.S. PUBLIC LAND SURVEY MONUMENT RECORD 28 CORNER NO. ADAMS COUNTY SECTION TYPE OF MONUMENT: Standard Harrison 18N TOWN STATE PLANE COORDINATES: 7E RANGE ELEVATION — M.S.L. DATUM: __ THETA ANGLE: FIELD BOOK: Adams County PAGE 45 DRAWN BY: D. Riesop BASIS FOR MONUMENT LOCATION Show info such as: History of corner, with reference to Vol. and pg., dates, surveyor; exact description of monument replaced; if location computed, by taped or EDM traverse; landowner remarks, etc. (Use reverse side if necessary) (in conformance with Section A-E 502 of the LOCATION (Indicated by 'X') ENTHURING STORY SEAL: Wisconsin Administrative Code) Found 3" diameter rotted wood stake while digging. Stake is 4 feet North of a straight line and within 0.3 feet of a split between adjacent section corners. DAVID C. RIESOP Stake was removed and monument set. Original bearing S-1551 trees and those marked in 1902 (Vol.3, P. 29, A. Co. CAMBR!DGE field notes) are gone. Took ties as shown filed for record this... day of .JUNE 19 ... DATA SHOWN HERE ON CERTIFIED CORRECT: per 59.60 Wisconsin Statutes. Registered Land Surveyor ADAMS COUNTY SURVEYOR 5/26/83 DATE: _ BURED PINE, TIE SKETCH Show at least four ties, also fence lines, roads, topo, size and type of witness trees' and if off road - best way to arrive at corner. "PIPE ROAD CORNER IS 10'5 SOUTH AND 101 ± EAST OF 42 EXTENDED SCALE 8 1"=30" MAINTENANCE RECORD Date Remarks Init. PIECES CR55 3-9-87 OK 52.50 GONE-NOMINE HUAL KZ-55 1- GONE- 2-NEW TIES

Candé

SI"IRON PIPE FOUND

FIELD

16

JB-55

2-21-07

OK

~ ;···