OT RANGE ADAMS COUNTY COUNTY CORNER NO: 29 ROMPORTOL ID: 41807030000

PUBLIC LAND SURVEY MONUMENT RECORD

TYPE OF MONUMENT:

HARRISON

ADAMS COUNTY COORDINATES, NAD 83 (2007)

N. 250944.387

E. 578036.409

ELEVATION- - --- DATUM

01/15/2020 FIELD WORK DATE:_


BASIS FOR MONUMENT LOCATION

1973 - PLS 878 FOUND RAILROAD SPIKE AND ACCEPTED AS CORNER AFTER A TRAVERSE OF ENTIRE SECTION. EXCAVATED LARGE AREA WITH BACKHOE, BUT FOUND NOTHING ELSE. REPLACED WITH HARRISON MONUMENT.

2020 - PLS 2675 FOUND HARRISON 6"± BELOW THE ROAD SURFACE AND 2 WITNESSES, THE MONUMENT AGREES WITH BOTH WITNESSES, ACCEPTED THE HARRISON AS THE CORNER LOCATION. SET 4 NEW TIES AND MEASURED TO THE EXISTING WITNESSES.



(INDICATE CORNER BY "X")

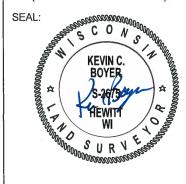

DATA SHOWN HERE ON THIS TIE SHEET IS CORRECT AND COMPLETE TO THE BEST OF MY KNOWLEDGE AND BELIEF.

PROFESSIONAL LAND SURVEYOR

2020


-TIE SKETCH

NOTE: THE CORNER LANDS 3.5'± NORTH OF COTTONVILLE AVE. CENTERLINE AND 3.5"± EAST OF 3RD AVE. CENTERLINE



- SET 3/4" x 18" IRON REBAR, 1.50#/FT
- FOUND HARRISON MONUMENT

VINYL "T" POST

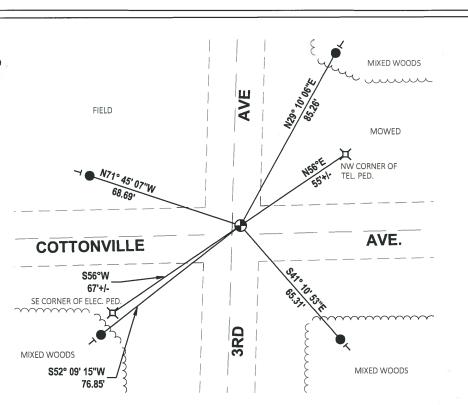

CORNER NO. 25 ADAMS COUNTY **SECTION** Survey Monument Record TOWN Harrison Std. TYPE OF MONUMENT: ____ RANGE STATE PLANE COORDINATES: N_ E. ELEVATION - M.S.L. DATUM: _ THETA ANGLE: _ FIELD BOOK: ____ (a 7 ____ PAGE <u>/ 9</u> 7 BASIS FOR MONUMENT LOCATION (Use reverse side if necessary) ANTHONY B. KIEDROWSKI S-878 Wisconsin Rapids. Wis. LOCATION Show info such as: History of corner, with reference to Vol. and pg, dates, surveyor; exact description of monument replaced; if location computed, by taped or EDM traverse; landowner SEAL: remarks, etc. Found railroad spike and accepted as corner after a traverse of entire section. Excavated large area with backhoe but found nothing else.

