# OT RANGE ADAMS COUNTY COUNTY CORNER NO: 35 ROMPORTOL ID: 41807072000

## PUBLIC LAND SURVEY MONUMENT RECORD

**HARRISON** TYPE OF MONUMENT: ADAMS COUNTY COORDINATES, NAD 83 (2007)

N. 248310.959

E. 562175.023


- — DATUM\_ - — —

FIELD WORK DATE: 01/07/2020


### BASIS FOR MONUMENT LOCATION

1983 - PLS 1551 SEARCHED AREA, NO SIGNS OF STAKE OR BEARING TREES. HARRISON WAS SET PROPORTIONALLY ON A STRAIGHT LINE BETWEEN ADJACENT SECTION CORNERS. POSITION USED FITS ORIGINAL DISTANCES WITHIN 2.5 FEET.

2020 - PLS 2675 FOUND HARRISON FLUSH WITH THE GROUND AND 4 WITNESSES. THE MONUMENT AGREES WITH ALL 4 WITNESSES. ACCEPTED THE HARRISON AS THE CORNER LOCATION. SET 4 NEW TIES AND MEASURED TO THE EXISTING WITNESSES.

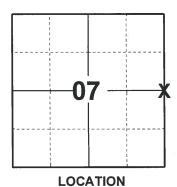

(INDICATE CORNER BY "X")

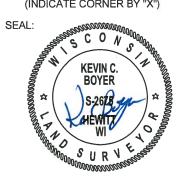


DATA SHOWN HERE ON THIS TIE SHEET IS CORRECT AND COMPLETE TO THE BEST OF MY KNOWLEDGE AND BELIEF.

PROFESSIONAL LAND SURVEYOR

#### -TIE SKETCH



- SET 3/4" x 18" IRON REBAR, 1.50#/FT
- FOUND HARRISON MONUMENT
- STEEL FENCE POST
- VINYL "T" POST
- WITNESS TREE
- WITNESS STUMP

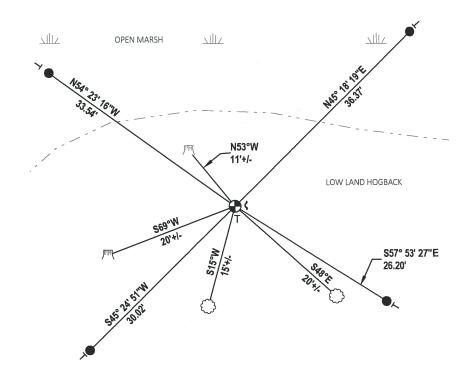

### U.S. PUBLIC LAND SURVEY MONUMENT RECORD CORNER NO. \_ 35 ADAMS COUNTY SECTION TYPE OF MONUMENT: Standard Harrison 18N **TOWN** STATE PLANE COORDINATES: 7E RANGE ELEVATION — M.S.L. DATUM: \_ THETA ANGLE: FIELD BOOK: Adams County PAGE 52 DRAWN BY: \_\_ D. Riesop BASIS FOR MONUMENT LOCATION Show info such as: History of corner, with reference to Vol. and pg., dates, surveyor; exact description of monument replaced; if location computed, by taped or EDM traverse; landowner remarks, etc. (Use reverse side if necessary) (in conformance with Section A-E 502 of the LOCATION (Indicated by 'X') SEAL: HINTINGONS IN THE Wisconsin Administrative Code ) Searched area, no signs of stake or bearing trees. DAVID C. Corner was reset proportionally on a straight line RIESOF between adjacent section corners. S-1551 CAMBRIDGE, WISCONSIN Position used fits original distances within 2.5 feet. DATA SHOWN HERE ON CERTIFIED\_CORRECT: Registered Land Surveyor *6/27/83* DATE: \_\_ "DEAA" TIE SKETCH THIN 10" POPLAR Show at least four ties, also fence lines, roads, topo, size NAIL IN WITRUNK and type of witness trees' and if off road - best way to HUNTING arrive at corner. PLATFORM filed for record this. day of STUMP per 59.60 Wisconshy/Statutes 12" POPLAR MAIL IN N. SIDE. ADAMS COUNTY SURVEYOR MAINTENANCE RECORD Date Init. Remarks 10-1-87 6-10-92 56-85 DNA SIGN DEAD 1-598 55

SCALE 81"=40'

COMPLETE AREA UNDERWATER

776

1 Now

JG

M5-55

1-24-02

10-19-07

10"TAMARACK

NAIL IN S. SIDE

H

and the second s