18

OT RANGE ADAMS COUNTY COUNTY CORNER NO: 36 ROMPORTOL ID: 41807082000

PUBLIC LAND SURVEY MONUMENT RECORD

2-3/8" O.D. IRON PIPE TYPE OF MONUMENT: ADAMS COUNTY COORDINATES, NAD 83 (2007)

N. 248249.721

E. 567431.080


__ DATUM_

01/08/2020 FIELD WORK DATE:


BASIS FOR MONUMENT LOCATION

1983 - PLS 1551 REMAINS OF BOTH ORIGINAL BEARING TREES WERE FOUND. PROBED CORNER AREA FOR STAKE, BUT NOTHING WAS FOUND. RESET CORNER FROM ORIGINAL TIES. THIS LOCATION FITS ORIGINAL DISTANCE FROM CORNER ESTABLISHED TO NORTH WITHIN 5 FEET.

2020 - PLS 2675 FOUND 2-3/8" O.D. IRON PIPE 18"± ABOVE THE ICE AND 3 WITNESS TREES. THE MONUMENT AGREES WITH ALL 3 WITNESS TREES. ACCEPTED THE 2-3/8" O.D. IRON PIPE AD THE CORNER LOCATION. SET 4 NEW TIES AND MEASURED TO THE EXISTING WITNESS TREES.

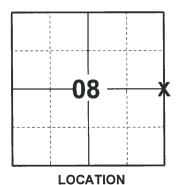

(INDICATE CORNER BY "X")

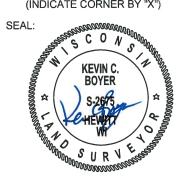


DATA SHOWN HERE ON THIS TIE SHEET IS CORRECT AND COMPLETE TO THE BEST OF MY KNOWLEDGE AND BELIEF.

PROFESSIONAL LAND SURVEYOR

-TIE SKETCH



- SET 3/4" x 18" IRON REBAR, 1:50#/FT
- FOUND 2-3/8" O.D. IRON PIPE
- STEEL FENCE POST
- VINYL "T" POST
- WITNESS TREE

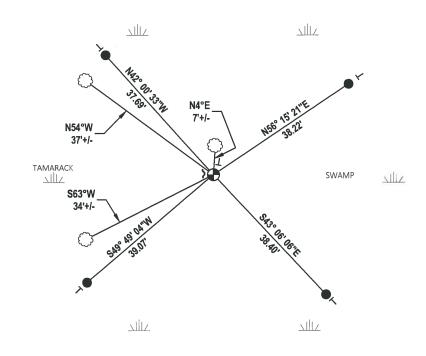

| ADAMS COUNTY TYPE OF MONUMENT: 2" I.D. x 60" galvanized pipe SECTION 9 TOWN 18N RANCE 7E ELEVATION — M.S.L. DATUM: THETA ANGLE: FIELD BOOK: Adams County PAGE 51 DRAWN BY: D. Riesop BASIS FOR MONUMENT LOCATION Show info such as: History of corner, with reference to Vol. and pg., dates, surveyor, exact description of monument replaced; if location computed, by taped or EDM inverses; landowner transks, etc. (Use revers side if necessary) (in conformance with Section A-E 502 of the Wisconsin Administrative Code) Remains of both original bearing trees were found. Probed corner area for stake, but nothing was found. Reset corner from original ties. This location fits original distance from corner established to North within 5 feet. DATA SHOWN HERE ON CERTIFIED CORRECT: Registered Land Surveyor DATE: C/24/83 TIE SKETCH TE DIA HOMMOCK, REMAINS OF ORLE. RESIDENT CORRECT: Registered Land Surveyor DATE: TIES SHOWN AR TO MALLS IN SET TIES THE SHOWN AR TO | U.S. PUBLIC LAND SURVEY MONUMENT RECORD | 36 |
|--|--|--|
| TYPE OF MONUMENT. 2" I.D. x 60" galvanized pipe TOWN ISN RANGE ELEVATION — M.S.L DATUM: THETA ANGLE: FIELD BOOK: Adams County PAGE 51 DRAWN BY: D. Riesop BASIS FOR MONUMENT LOCATION Show info such as: History of corner, with reference to Vol. and Tpe, dates, surveyor; exert description of promunent replaced; if location computed, by taped or EDM traverse; landowner remais, etc. (Use reverse side if measters) (in conformance with Section Act 502 of the Wisconian Administrative Code. This location fits original bearing trees were found. Probed corner area for stake, but nothing was found. Reset corner from original ties. This location fits original distance from corner established to North within 5 feet. SEAL: THE SKETCH Show at less four its, sho four line, rolds, topo, size and type of witness trees and if off road - best way to any arrive at corner. THE SKETCH Show at less four its, sho four line, rolds, topo, size to and type of witness trees and if off road - best way to any to the state of the corner. THE SKETCH Show at less four its, sho four line, rolds, topo, size to any to any topo size and type of witness trees and if off road - best way to any topo size at corner. ADAMS COUNTY SURVEYOR MAINTENANCE RECORD Date Init. Remarks 1-24-2-2 Z. 15 FABLY III CORNER DEC. 24-2-7 O OL. SEAL: TOWN ISN RANGE TOWN ISN RANGE TOWN RANGE TOWN RANGE TOWN ISN RANGE TOWN RANGE TOWN IND RANGE TOWN IND RANGE TOWN ISN RANGE TOWN IND RANGE TOWN Indicated by X') SEAL: WISCONTON REMAINS OF ORIG. TOWN IND RANGE TOWN Indicated by X') SEAL: WISCONTON Indicated by X') IND REMAINS OF ORIG. REMAINS OF ORIG. REMAINS O | ADAMS COUNTY | CORNER NO. 36 |
| STATE PLANE COORDINATES: N. E. TOWN 18N RANCE 7E ELEVATION — M.S.L. DATUM: THETA ANGLE: FIFLD BOOK: Adams County PAGE 51 DRAWN BY: D. Riesop BASIS FOR MONUMENT LOCATION Show info such as: History of corner, with reference to Vol. replaced; if location computed, by taped or EDM traverse; landowner remarks, etc. (Use reverse side if necessary) (in conformone with Section 4-5 502 of the Wisconsin Administrative Code) Remains of both original bearing trees were found. Probed corner area for stake, but nothing was found. Reset corner from original ties. This location fits original distance from corner established to North within 5 feet. DATA SHOWN HERE ON CERTIFIED CORRECT: Registered Land Surveyor DATE: C124/B3 TIE SKETCH Show at least four ites, also fence lines, roads, topo, size and type of witness trees and if off road - best way to arrive at corner. TO MALLS III S. Stock Wisconsin Shortos. MAINTENANCE RECORD Date Init. Remarks WISCONSA ADAMS COUNTY SURVEYOR MAINTENANCE RECORD Date Init. Remarks WISCONSA LICE STILL MONAGE. TO MALLS III S. Stock Wisconsin Shortos. WISCONSA ADAMS COUNTY SURVEYOR MAINTENANCE RECORD Date Init. Remarks WISCONSA LICE STILL MONAGE. TO MALLS III S. Stock Wisconsin Shortos. WISCONSA LICE STILL SHOWN AREA ON THE CORNER DE DE CALLE S 1"-BO No TREES SIGN STILL SHOWN AREA ON THE CALLES SIGN STILL | | SECTION 9 |
| ELEVATION — M.S.L. DATUM: THETA ANGLE: FIELD BOOK: Adams County PAGE 51 DRAWN BY: D. Riesop BASIS FOR MONUMENT LOCATION Show info such as: History of comer, with reference to Vol. and yee, dates, surveyor, exact description of monument respirace, if hostion computed, by taped or EDM traverse; (Indicated by X) Remains of both original bearing trees were found. Probed corner area for stake, but nothing was found. Reset corner from original ties. This location fits original distance from corner established to North within 5 feet. This location fits original distance from corner established to North within 5 feet. THE SKETCH Show at least four ites, also fence lines, roads, topo, size and type of witness trees and if off road - best way to arrive at corner. THE SKETCH Show at least four ites, also fence lines, roads, topo, size and type of witness trees and if off road - best way to arrive at corner. THE SKETCH MAINTENANCE RECORD Date Init. Remarks Wisconsty Statutes ADAMS COUNTY SURVEYOR MAINTENANCE RECORD Date Init. Remarks U. No Taes Sign Called P. Pos | | TOWN 18N |
| ELEVATION — M.S.L. DATUM: THETA ANGLE: THE SASIS FOR MONUMENT LOCATION Show info such as: History of comer, with reference to Vol. and 12g., dates, surveyor; exact description of monument replaced, if location compared, by staged or Elevatory: (in conformance with Section A-E 502 of the Wisconsin Administrative Code) Remains of both original bearing trees were found. Probed corner area for stake, but nothing was found. Reset corner from original ties. This location fits original distance from corner established to North within 5 feet. DATA SHOWN HERE ON CERTIFIED CORRECT: Registered Land Surveyor DATE: DATE SUPPLY REGISTER Land Surveyor DATE: TE SKETCH Show at less four size, also fence lines, roads, topo, size and type of winness trees and if off road best way to arrive at corner. TO MALLS ILL 25 SOLO Wiscords from the surveyor and the surveyor and type of winness trees and if off road best way to arrive at corner. MAINTENANCE RECORD Date Init. Remarks 12ft Mean Title Coanies Dic. ADAMS CULHTY SURVEYOR MAINTENANCE RECORD Date Init. Remarks 12ft Mean Title Coanies Dic. 12ft Mean Ti | | RANGE <u>7E</u> |
| THETA ANGLE: FIELD BOOK: Adams County PAGE 51 DRAWN BY: D. Riesop BASIS FOR MONUMENT LOCATION Show info such as: History of come, with reference to Vol. and 192, dates, surveyor; exect description of monument replaced, if location computed, by taped or EDM traverse; (in conformace with Section 4-£ 502 of the Wisconsin Administrative Code) Remains of both original bearing trees were found. Probed corner area for stake, but nothing was found. Reset corner from original ties. This location fits original distance from corner established to North within 5 feet. DATE: | | |
| FIELD BOOK. Adams County PAGE 51 DRAWN BY: D. Riesop BASIS FOR MONUMENT LOCATION Show info such as: History of corner, with reference to Vol. and Pg. dates, surveyor exact description of monument replaced; if location computed, by taped or EDM traverse; landowner remarks, car. (Use reverse side if necessary) (in conformance with Section AE 5020 the Wisconsin Administrative Code) Remains of both original bearing trees were found. Probed corner area for stake, but nothing was found. Reset corner from original ties. This location fits original distance from corner established to North within 5 feet. This location fits original distance from corner established to North within 5 feet. This location fits original distance from corner established to North within 5 feet. This location fits original distance from corner established to North within 5 feet. This location fits original distance from corner established to North within 5 feet. This location fits original distance from corner established to North within 5 feet. This location fits original distance from corner established to North within 5 feet. This location fits original distance from corner established to North within 5 feet. This location fits original distance from corner established to North within 5 feet. This location fits original distance from corner established to North within 5 feet. This location fits original ties. This location fit original ties. This location fits original ties. This location fits original ties. This location fits original ties. | | |
| BASIS FOR MONUMENT LOCATION Show info such as: History of comer, with reference to Vol. and Pg., dates, surveyor; exact description of monument replaced; if location computed, by taped or EDM travers; landowner remarks, etc. (Use reverse side if mecessary) (in conformace with Section Administrative Code) Remains of both original bearing trees were found. Probed corner area for stake, but nothing was found. Reset corner from original ties. This location fits original distance from corner established to North within 5 feet. DATE: DA | FIELD BOOK: Adams County PAGE 51 | |
| Show info such as: History of comer, with reference to Vol. and pg., dutes, surveyor, exact description of monument and pg., dutes, surveyor, exact description of monument and probability of the measures of | — — — — — — — — — — — — — — — — — — — | 4 0 1 |
| Show info such as: History of corner, with reference to Vol. and pg., dutes, surveyor, exact description of mormanent and pg., dutes, surveyor, exact description of mormanent and probability of the probability of more description of more descript | | |
| Show info such as: History of corner, with reference to Vol. and pg., dutes, surveyor, exact description of mormanent and pg., dutes, surveyor, exact description of mormanent and probability of the probability of more description of more descript | RASIS FOR MONITIMENT LOCATION | |
| and pg., dates, surveyor, exact description of monument replaced; it location computed, by taped or EBM traverse; landowner remarks, etc. (Use reverse side if necessary) (in conformance with Section Administrative Code) Remains of both original bearing trees were found. Probed corner area for stake, but nothing was found. Reset corner from original ties. This location fits original distance from corner established to North within 5 feet. DATA SHOWN HERE ON CERTIFIED CORRECT: Registered Land Surveyor DATE: OLIVICATION (Indicated by X) SEAL: INCOMPRISON ADAIDS CONSIN WISSONSIN DAYING CONSIN WISSONSIN DATA SHOWN HERE ON CERTIFIED CORRECT: Registered Land Surveyor DATE: OLIVICATION (Indicated by X) SEAL: INCOMPRISON REMANANCE RECORD TECHNOLOGY DATE: OLIVICATION (Indicated by X) SEAL: INCOMPRISON AMERIDAE ADAMS COUNTY SURVEYOR MAINTENANCE RECORD Date Init. Remarks OLIVICATION (Indicated by X) SEAL: INCOMPRISON INOMPRISON INCOMPRISON INCOMPRISON INCOMPRISON INCOMPRISON INC | | |
| Remains of both original bearing trees were found. Probed corner area for stake, but nothing was found. Reset corner from original ties. This location fits original distance from corner established to North within 5 feet. DATA SHOWN HERE ON CERTIFIED CORRECT: Registered Land Surveyor DATE: DATE: DATE: DATE: TE SKETCH Show at least four ites, also fence lines, roads, topo, size and type of winters trees and if off road best way to arrive at corner. TO MAILS IN S. BLAZED TAMARA ADAMS COUNTY SURVEYOR MAINTENANCE RECORD Date Init Remarks 1-34-12 Z-15 New 7112 Coenter Dic Corner Counter Counter Dic Contents CALLE S 1"=30 W/ No TRES SIGN CARLE S 1"=30 W/ No TRES SIGN CARLE S 1"=30 CALLE S 1"=30 CAL | Show into such as: History of corner, with reference to Vol. and pg., dates, surveyor; exact description of monument | |
| Remains of both original bearing trees were found. Probed corner area for stake, but nothing was found. Reset corner from original ties. This location fits original distance from corner established to North within 5 feet. DATA SHOWN HERE ON CERTIFIED CORRECT: Registered Land Surveyor DATE: DATE: DATE: DATE: TE SKETCH Show at least four ites, also fence lines, roads, topo, size and type of winters trees and if off road best way to arrive at corner. TO MAILS IN S. BLAZED TAMARA ADAMS COUNTY SURVEYOR MAINTENANCE RECORD Date Init Remarks 1-34-12 Z-15 New 7112 Coenter Dic Corner Counter Counter Dic Contents CALLE S 1"=30 W/ No TRES SIGN CARLE S 1"=30 W/ No TRES SIGN CARLE S 1"=30 CALLE S 1"=30 CAL | replaced; if location computed, by taped or EDM traverse; landowner remarks, etc. (Use reverse side if necessary) | |
| Remains of both original bearing trees were found. Probed corner area for stake, but nothing was found. Reset corner from original ties. This location fits original distance from corner established to North within 5 feet. DATA SHOWN HERE ON CERTIFIED CORRECT: Registered Land Surveyor DATE: DATE: TESSETCH Show at least four ties, also fence lines, roads, topo, size and type of witness trees and if off road - best way to arrive at corner. TAM. ST. MAINTENANCE RECORD Date Init Remarks -34-0.3 5.15 New Till Gerner Dic Grant Corner Conditions of the Conditions o | (in conformance with Section A-E 502 of the SEA | L: |
| This location fits original distance from corner established to North within 5 feet. DATA SHOWN HERE ON CERTIFIED CORRECT: Registered Land Surveyor DATE: C/24/83 TE SKETCH Show at least four ties, also fence lines, roads, topo, size and type of wintess trees' and if off road - best way to arrive at corner. ADAMS COUNTY SURVEYOR MAINTENANCE RECORD Date Init. Remarks 13-34-0 & X-J5 New TIE BORNER DIC. CAMBRIDGE, WISCONSIN DATA SHOWN HERE ON CERTIFIED CORRECT: Registered Land Surveyor DATE: C/24/83 TZ DIA. HOMMOCK, REMANUS OF ORIG. TAM. BT. WISCONSIN DATE: TO MAILS INI 8" BLAZED TAMARE BY TAM GRACK DATE SURVEYOR MAINTENANCE RECORD Date Init. Remarks C-24-0 A X-J5 New TIE BORNER DIC. CORNER CORNER | Wisconsin Administrative Code) | ALIMANIA MARIA |
| This location fits original distance from corner established to North within 5 feet. DATA SHOWN HERE ON CERTIFIED CORRECT: Registered Land Surveyor DATE: C/24/83 TE SKETCH Show at least four ties, also fence lines, roads, topo, size and type of wintess trees' and if off road - best way to arrive at corner. ADAMS COUNTY SURVEYOR MAINTENANCE RECORD Date Init. Remarks 13-34-0 & X-J5 New TIE BORNER DIC. CAMBRIDGE, WISCONSIN DATA SHOWN HERE ON CERTIFIED CORRECT: Registered Land Surveyor DATE: C/24/83 TZ DIA. HOMMOCK, REMANUS OF ORIG. TAM. BT. WISCONSIN DATE: TO MAILS INI 8" BLAZED TAMARE BY TAM GRACK DATE SURVEYOR MAINTENANCE RECORD Date Init. Remarks C-24-0 A X-J5 New TIE BORNER DIC. CORNER CORNER | | MINISCONS / III |
| This location fits original distance from corner established to North within 5 feet. DATA SHOWN HERE ON CERTIFIED CORRECT: Registered Land Surveyor DATE: C/24/83 TE SKETCH Show at least four ties, also fence lines, roads, topo, size and type of wintess trees' and if off road - best way to arrive at corner. ADAMS COUNTY SURVEYOR MAINTENANCE RECORD Date Init. Remarks 13-34-0 & X-J5 New TIE BORNER DIC. CAMBRIDGE, WISCONSIN DATA SHOWN HERE ON CERTIFIED CORRECT: Registered Land Surveyor DATE: C/24/83 TZ DIA. HOMMOCK, REMANUS OF ORIG. TAM. BT. WISCONSIN DATE: TO MAILS INI 8" BLAZED TAMARE BY TAM GRACK DATE SURVEYOR MAINTENANCE RECORD Date Init. Remarks C-24-0 A X-J5 New TIE BORNER DIC. CORNER CORNER | | |
| This location fits original distance from corner established to North within 5 feet. DATA SHOWN HERE ON CERTIFIED CORRECT: Registered Land Surveyor DATE: C/24/83 TE SKETCH Show at least four ties, also fence lines, roads, topo, size and type of wintess trees' and if off road - best way to arrive at corner. ADAMS COUNTY SURVEYOR MAINTENANCE RECORD Date Init. Remarks 13-34-0 & X-J5 New TIE BORNER DIC. CAMBRIDGE, WISCONSIN DATA SHOWN HERE ON CERTIFIED CORRECT: Registered Land Surveyor DATE: C/24/83 TZ DIA. HOMMOCK, REMANUS OF ORIG. TAM. BT. WISCONSIN DATE: TO MAILS INI 8" BLAZED TAMARE BY TAM GRACK DATE SURVEYOR MAINTENANCE RECORD Date Init. Remarks C-24-0 A X-J5 New TIE BORNER DIC. CORNER CORNER | | DAVID C. |
| DATA SHOWN HER ON CERTIFIED CORRECT: Registered Land Surveyor DATE: C/24/83 TIE SKETCH Show at least four ties, also fence lines, roads, topo, size and type of witness trees and if off road - best way to arrive at corner. 12. DIA. HUMMOCK, REMANUS OF ORIG. TAM. BT. TO MAILS IN 8" BLAZED TAMARA STAM ARACK DATE: MICTE'S TIES SHOWIN AR TO MAILS IN 8" BLAZED TAMARA STAM ARACK DATE: MICTE'S TIES SHOWIN AR TO MAILS IN 8" BLAZED TAMARA STAM ARACK DATE: MICTE'S TIES SHOWIN AR TO MAILS IN 8" BLAZED TAMARA STAM ARACK DATE: MINTENANCE RECORD Date Init Remarks 12-4-0-2 JC OK CORNER WINTENANCE RECORD CORNER COR | | S.1551 |
| DATA SHOWN HERE ON CERTIFIED CORRECT: Registered Land Surveyor DATE: C/24/83 TIE SKETCH Show at least four ties, also fence lines, roads, topo, size that the said type of witness trees and if off road best way to arrive at corner. TAM. BT. ADAMS COUNTY SURVEYOR MAINTENANCE RECORD Date Init. Remarks 13.86 MAINTENANCE RECORD Date Init. Remarks 1.17 | | CAMBRIDGE, WISCONSIN |
| TIE SKETCH Show at least four ties, also fence lines, roads, topo, size and type of witness trees' and if off road - best way to arrive at corner. TO MAILS IN 8 BLAZED TAMARA TO MAILS IN 8 TO MAIL | established to North within 5 feet. | |
| TIE SKETCH Show at least four ties, also fence lines, roads, topo, size and type of witness trees' and if off road - best way to arrive at corner. TO MAILS IN 8" BLAZED TAMARA TO MAINTENANCE RECORD MAINTENANCE RECORD Date Init. Remarks W/No TRES SIGN CORNER CORNER CORNER CORNER CORNER | 1 | The second of th |
| TIE SKETCH Show at least four ties, also fence lines, roads, topo, size and type of witness trees' and if off road - best way to arrive at corner. TO MAILS IN 8" BLAZED TAMARA TO MAINTENANCE RECORD MAINTENANCE RECORD Date Init. Remarks W/No TRES SIGN CORNER CORNER CORNER CORNER CORNER | | SURSIN |
| TIE SKETCH Show at least four ties, also fence lines, roads, topo, size and type of witness trees' and if off road - best way to arrive at corner. TO MAILS IN 8" BLAZED TAMARA TO MAILS IN 8" | _ | · · · · · · · · · · · · · · · · · · · |
| Show at least four ties, also fence lines, roads, topo, size and type of witness trees' and if off road - best way to arrive at corner. TO MAILS IN 8" BLAZED TAMARA TO MAILS IN 8" BLAZED TAMARA STOM ARACK DAND SIGN FACUS OF ORIGE. MAINTENANCE RECORD Date Init. Remarks 1"=30 MAINTENANCE RECORD Date Init. Remarks 1"=30 LITE METAL POS W/No TRES SIGN CORNER CORNER CORNER | DA | TE: <u>6/24/83</u> |
| ADAMS COUNTY SURVEYOR MAINTENANCE RECORD Date Init. Remarks 1-34-02 & JS -New TIE CORNER DK 0-9-07 JC OK | Show at least four ties, also fence lines, roads, topo, size TAM. BT. and type of witness trees' and if off road - best way to | NOTES TIES SHOWN AR TO MAILS IN 8" BLAZED TAMARA |
| ADAMS COUNTY SURVEYOR MAINTENANCE RECORD Date Init. Remarks 1-24-02 & JS I-NEW TIE CORNER DIC DOCUMENTO DIC DIC CORNER DIC CORNER | يَّةٍ: | Son MM |
| ADAMS COUNTY SURVEYOR MAINTENANCE RECORD Date Init. Remarks 1-24-02 & JS I-NEW TIE CORNER DIC O-9-07 JC OK DATE OF ORIGE CORNER DATE DAT | E TOOK I | NE AU |
| ADAMS COUNTY SURVEYOR ADAMS COUNTY SURVEYOR MAINTENANCE RECORD Date Init. Remarks 1-24-02 & JS I-NEW TIE CORNER DIC O-9-07 JC OK DATE OF CRIS. CORNER CORNER DATE OF CRIS. W/NO TRES SIGN CORNER CORNER DATE OF CRIS. DATE OF CRIS. CORNER D | Lely 10 83 | WET- |
| ADAMS COUNTY SURVEYOR SCALE S 1"=30' MAINTENANCE RECORD Date Init. Remarks 1-24-02 & JS I-NEW TIE CORNER DK 0-9-07 JC OK DAND SIGN PROOFS OF ORIG. ROOTS OF ORIG. W/NO TRES SIGN CORNER CORNER | 59.60 Wisconsin Statutes. | 8 TAM GRACK QOZT |
| MAINTENANCE RECORD Date Init. Remarks 1-24-02 E-JS I-NEW TIE CORNER DK 0-9-07 JC OK ROOTS OF ORIG. TAM. BT. ROOTS OF ORIG. TAM. BT. W/NO TRES S/GN CORNER | M. Chinetan | DNO SICH ENCESTS |
| MAINTENANCE RECORD Date Init. Remarks 1-24-02 SE-JS I-NEW TIE CORNER DIC 0-9-07 JC OK MAINTENANCE RECORD LITE METAL POS W/NO TRES SIGN CORNER | ADAMS COUNTY SURVEYOR | Be NOZ |
| MAINTENANCE RECORD Date Init. Remarks 1-24-02 E-JS I-NEW TIE CORNER DK 0-9-07 JC OK | IN BOXE | |
| Date Init. Remarks W/NO TRES SIGN 1-24-02 SE-JS I-NEW TIE CORNER DIC 0-9-07 JC OK CRNER | | , , |
| 0-24-02 JE-JS I-NEW TIE CORNER DIC OFFICE OF OK | WW. Sole | |
| 0-9-07 JC OK | 3 | W NO TRES SIGN |
| | WIII. | and I'm |
| 12-48-12 MS OK | 48 | 0. |
| Wik. | 12-28-12 MS OK | , / |
| | | \ e |