18

OT RANGE ADAMS COUNTY COUNTY CORNER NO: 37 ROMPORTOL ID: 41807092000

PUBLIC LAND SURVEY MONUMENT RECORD

TYPE OF MONUMENT:

3/4" IRON ROD

ADAMS COUNTY COORDINATES, NAD 83 (2007)

N. 248242.557

E. 572756.347

ELEVATION-

DATUM

FIELD WORK DATE:


01/08/2020

BASIS FOR MONUMENT LOCATION

1983 - PLS 1551 SET CORNER ON LINE AND AT PROPORTIONATE DISTANCE BETWEEN THE ADJACENT SECTION CORNERS.

2001 - PLS 2441 DISCOVERED THE 2" I.D. IRON PIPE INTENDING TO MONUMENT THIS CORNER TO BE DISTURBED. PULLED BACK THE TIES PER PLS 1551, WHICH DID NOT MATCH THE PHYSICAL LOCATION EITHER. EXTENDED THE WEST AND SOUTH LINES OF LOT 1 OF CSM 2200 TO THEIR INTERSECTION AND MONUMENTED THIS LOCATION AS THE CORRECT POSITION OF THIS CORNER.

2020 - PLS 2675 FOUND 3/4" IRON ROD 6"± BELOW THE WATER. 1 TIE. AND 1 WITNESS. THE MONUMENT AGREES WITH THE TIE AND WITNESS. ACCEPTED THE 3/4" IRON ROD AS THE CORNER LOCATION. SET 4 NEW TIES AND MEASURED TO THE EXISTING TIE AND WITNESS.

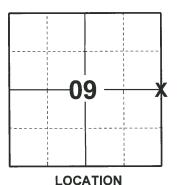

(INDICATE CORNER BY "X")



DATA SHOWN HERE ON THIS TIE SHEET IS CORRECT AND COMPLETE TO THE BEST OF MY KNOWLEDGE AND BELIEF.

PROFESSIONAL LAND SURVEYOR


2020

-TIE SKETCH



- SET 3/4" x 18" IRON REBAR, 1.50#/FT
- FOUND 2-3/8" O.D. IRON PIPE
- FOUND 3/4" IRON ROD
- VINYL "T" POST

MITNESS STUMP

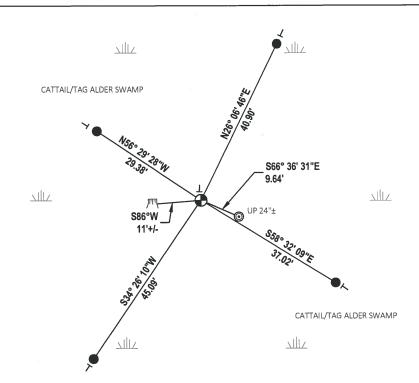

U.S PUBLIC LAND SURVEY MONUMENT RECORD ADAMS COUNTY, WISCONSIN

CORNER NO. 37 SECTION 10 TOWN 18N RANGE 7E


TYPE OF MONUMENT: 3/4" X 24" ROUND IRON ROD

STATE PLANE COORDINATES: N: NOT APPLICABLE
E: NOT APPLICABLE

ELEVATION _ MSL DATUM: NOT APPLICABLE THETA ANGLE:NOT APPLICABLE

FIELD BOOK: 98 PAGE 01

DRAWN BY: CHRISTOPHER J. RENNER

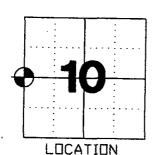

BASIS FOR MONUMENT LOCATION

THIS CORNER WAS SET BY DAVID C. RIESOP ON LINE AND AT PROPORTIONATE DISTANCE BETWEEN THE ADJACENT SECTION CORNERS ON 27 JULY, 1983. WHILE PERFORMING A TRAVERSE AROUND LOT 1 OF ADAMS COUNTY CERTIFIED SURVEY MAP NO. 2200 I DISCOVERED THE 2° I.D. IRON PIPE INTENDING TO MONUMENT THIS CORNER TO BE DISTURBED. I PULLED BACK THE TIES PER DAVID RIESOP, WHICH DID NOT MATCH THE PHYSICAL LOCATION EITHER. I EXTENDED THE WEST AND SOUTH LINES OF LOT 1 OF C.S.M. 2200 TO THEIR INTERSECTION AND MONUMENTED THIS LOCATION AS THE CORRECT POSITION OF THIS CORNER.

SEAL



DATA SHOWN HEREON CERTIFIED CORRECT:

REGISTERED LAND SURVEYOR DATE: 25 OCTOBER, 2001

TIE SKETCH

TIES ARE TO NAILS DRIVEN AT THE BASE OF THE TREE.

