## OT RANGE ADAMS COUNTY COUNTY CORNER NO: 42 ROMPORTOL ID: 41807070020

## PUBLIC LAND SURVEY MONUMENT RECORD

**HARRISON** TYPE OF MONUMENT:\_ ADAMS COUNTY COORDINATES, NAD 83 (2007) N. 245603.842

**ELEVATION-**DATUM


01/07/2020 FIELD WORK DATE:

E. 559552.842

## BASIS FOR MONUMENT LOCATION

1983 - PLS 1551 EXISTING WHITE OAK REPORTED AS BEARING TREE BY OLDER LAND OWNER ACCEPTED AS SUCH EXCAVATED CORNER AREA WITH SHOVEL, BUT NO TRACE OF STAKE WAS FOUND. HARRISON MONUMENT WAS RESET FROM ORIGINAL TIE. CORNER LOCATION SPLITS REMAINS OF OLD ROAD RIGHT OF WAY FENCE NORTH AND SOUTH OF CORNER AND OLD N-S FENCE WIRE WAS FOUND LEADING INTO CORNER, THIS POSITION ALSO AGREES CLOSELY WITH ORIGINAL SECTION MEASUREMENTS FROM THE EAST.

2020 - PLS 2675 FOUND HARRISON MONUMENT FLUSH WITH THE GROUND AND 4 WITNESS TREES. THE MONUMENT AGREES WITH ALL 4 WITNESS TREES. ACCEPTED THE HARRISON AS THE CORNER LOCATION. SET 4 NEW TIES AND MEASURED TO THE EXISTING WITNESS TREES.

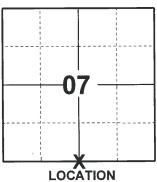

(INDICATE CORNER BY "X")



DATA SHOWN HERE ON THIS TIE SHEET IS CORRECT AND COMPLETE TO THE BEST OF MY KNOWLEDGE AND BELIEF.


PROFESSIONAL LAND SURVEYOR

## -TIE SKETCH

NOTE: THE CORNER LANDS 2.5'± SOUTH OF THE EDGE OF TRAIL.



- SET 3/4" x 18" IRON REBAR, 1.50#/FT
- FOUND HARRISON MONUMENT
- STEEL FENCE POST
- VINYL "T" POST
- WITNESS TREE

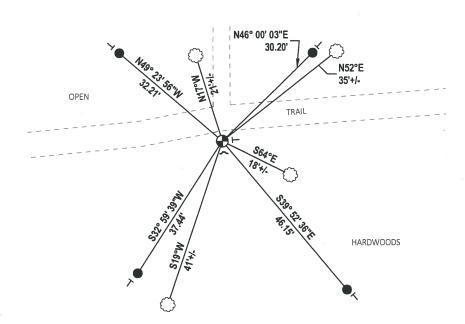

ADAMS COUNTY	2	
	CORNER NO	42
ADAMS COUNTY TYPE OF MONUMENT:Standard Harrison	SECTION	7
STATE PLANE COORDINATES: N	TOWN	18N
E	RANGE	7E
ELEVATION — M.S.L. DATUM:		
THETA ANGLE:		
FIELD BOOK: Adams County PAGE 53		
DRAWN BY: _D. Riesop	-	7.
		- N
BASIS FOR MONUMENT LOCATION		114
Show info such as: History of corner, with reference to Vol.		
and pg., dates, surveyor; exact description of monument	Li_X_i.	
and pg., dates, surveyor; exact description of monument replaced; if location computed, by taped or EDM traverse; landowner remarks, etc. (Use reverse side if necessary) (in conformance with Section A-E 502 of the	LOCATION (Indicated by X')	· <b>)</b>
(in conformance with Section A-E 502 of the Wisconsin Administrative Code )	SEAL:	
Existing White Oak reported as bearing tree by older	**************************************	100.
land owners accepted as such. Excavated corner area	HALL CON	Sign
with shovel, but no trace of stake was found. Monument	HIN W. Lawrence	
was reset from original tie.	DAVID C	
Corner location splits remains of old road right of	RIESOF S-1551	<b>1</b>
way fence North and South of corner and old N-S fence	CAMERIDO	
wire was found leading into corner.	WISCONS	™ <b>,(03</b>
This position also agrees closely with original	SILE SILE	V. Erret
section measurements from the East.	7///1111111	(100)
	DATA SHOWN HERE ON	1 /2
CAV O7 Live and Live Marketine	CERTIFIED CORRECT:	
per 59.60 Wisconsin Statutes.	Laid C	Sien
· · · · · · · · · · · · · · · · · · ·	Registered Land Surveyor	
ADAMS COUNTY SURVEYOR	DATE:	183
TIE SKETCH REMAILS OF	DOWN ORIGINAL N.E.	BT.
OLD FENCE	NOW ZH'WHI	TE OAK,
Show at least four ties, also fence lines, roads, topo, size	I DE BKUKEN	AND HOLLOW/S/GZ
and type of witness trees and if off road - best way to	<del>- x</del>	(A)
and type of witness trees' and if off road - best way to	× /6/2 ×	7"BLACK O
and type of witness trees' and if off road - best way to arrive at corner.  5" BLACK OAK, NAIL IN E. SIDE (,		7"BLACK O
and type of witness trees' and if off road - best way to arrive at corner.  5" BLACK OAK,		(C) MAIL IN N.
and type of witness trees' and if off road - best way to  arrive at corner.  5" BLACK OAK,  NAIL IN E. SIDE  SIGN	NO STATE OF THE ST	(C) MAIL IN N.
and type of witness trees' and if off road - best way to arrive at corner.  5" BLACK OAK, UAIL IN E. SIDE (,	NICO STATE OF THE	(C) MAIL IN N.
and type of witness trees' and if off road - best way to arrive at corner.  5" BLACK OAK, NAIL IN E. SIDE SIGN	NO THE PROPERTY OF THE PARTY OF	(C) MAIL IN N.
and type of witness trees' and if off road - best way to  S"BLACK OAK,  NAIL IN E. SIDE  STOWN		AMIL IN N.
and type of witness trees' and if off road - best way to  S"BLACK OAK,  NAIL IN E. SIDE  STOWN	18. Ses-51	MAIL IN N. SIDE
and type of witness trees' and if off road - best way to arrive at corner.  5"BLACK OAK, NAIL IN E. SIDE STOWN TRAIL	18.15 51 2' of meral	HAIL IN N. SIDE  1 44.80'  2057   DEAD 67 WRIER 6" BLACK
MAINTENANCE RECORD  Maintess trees' and if off road - best way to  S"BLACK OAK,  NAIL IN E. SIDE  TRAIL  TRAIL  TRAIL	18.15.55 2' or meran	E 44.80 LA STORE WENER G'BLACK OAK, NAIL
MAINTENANCE RECORD  Maintenance Record  Maintenance Record  Remarks  Maintenance rees and if off road - best way to  S"BLACK OAK,  NAIL IN E. SIDE  STOWN  TRAIL  TRAIL  NAINTENANCE RECORD  TWING 6" & 8"  BLACK OAK,  STOWN  STO	18.15.55 2'or meran	E 44.80 LA STORE WENER G'BLACK OAK, NAIL
MAINTENANCE RECORD  MAINTENANCE RECORD  Date Init. Remarks  Date Init. Remarks  NAIL IN E. SIDE  TWAN 6" & 8"  BLACK OAK,  NAIL IN E. SIDE  TWAN 6" & 8"  BLACK OAK,  NAIL IN E. SIDE  TWAN 6" & 8"  BLACK OAK,  NAIL IN W. SIDE  OF 6"	18.15.55 2' OF METAL WEST OF	HAIL IN N. SIDE  #4.80  DEAD OF WANER ONK, NAIL IN S. SIDE
MAINTENANCE RECORD  Date Init. Remarks  Date Init. Remarks  1 1 1 1 1 1 1 1 1 1 1 1 1 1 1 1 1 1 1	18.505051 2' OF METAL WEST OF	HAIL IN N. SIDE  144.80'  1057   DEAD 67 WRNER G'BLACK OAK, NAIL IN S. SIDE
MAINTENANCE RECORD  Date Init. Remarks	18.15.55 2' OF METAL WEST OF REMAINS	HAIL IN N. SIDE  HAID IN N. SIDE  POST "DEAD OT EVENER G"BLACK OAK, NAIL IN S. SIDE  "MAPLE /BT DNO SIGN OF OLD
MAINTENANCE RECORD  MAINTENANCE RECORD  Date Init. Remarks  10-10-97 5-55 OK  10-97 5-55 OK	18.15.55 2' OF METAL WEST OF REMAINS	HAIL IN N. SIDE  1/E 44.80'  1/2 1/2 1/2 1/2 1/2 1/2 1/2 1/2 1/2 1/2
MAINTENANCE RECORD  MAINTENANCE RECORD  Date Init. Remarks    Delication   Content   C	18.15.55 2' OF METAL WEST OF REMAINS	HAIL IN N. SIDE  HAID IN N. SIDE  POST "DEAD OT EVENER G"BLACK OAK, NAIL IN S. SIDE  "MAPLE /BT DNO SIGN OF OLD

en grower mag Dominion amerikanski statisk at de nast Grower Danis en statisk at de nast de nast de nast de nast de Grower de nast de nast