18

OT RANGE ADAMS COUNTY COUNTY CORNER NO: 45 ROMPORTOL ID: 41807080000

PUBLIC LAND SURVEY MONUMENT RECORD

1-1/2" O.D. IRON PIPE TYPE OF MONUMENT: ADAMS COUNTY COORDINATES, NAD 83 (2007)

N. 245604.340

E. 567471.840

ELEVATION-DATUM

01/08/2020 FIELD WORK DATE:


BASIS FOR MONUMENT LOCATION

1977 - PLS 1245 RAN EDM TRAVERSE AROUND SECTION 16 AND TIED IN ALL EXISTING EVIDENCE. SET HARRISON MONUMENT AT RECORD DISTANCE FROM EAST AND SOUTH.

1978 - PLS 1184 USING EDM TRAVERSE BEGINNING AT THE SE AND SW CORNERS OF SECTION 16, SET BY KIEDROWSKI, AND FOLLOWING THE ORIGINAL SECTION MEASUREMENTS, AS RECORDED IN VOL. 8, PG 18, AND VOL. 3, PG. 6 OF 1901 AND 1925 SURVEY NOTES PLS 1184 LOCATED THE WEST 1/4 POST OF SECTION 17 AND SET A MONUMENT AT THE BASE OF POST. THEN CALCULATED THE LOCATION OF AND SET THE NW CORNER OF SECTION 16.

1983 - PLS 1551 AREA WAS SEARCHED FOR OLD POST, OCCUPATION AND BEARING TREES, NOTING WAS FOUND. PLS 1551 DISAGREED WITH THE MONUMENT SET BY GREEN IN 1978 BECAUSE OF THE LARGE DISCREPANCY IN ORIGINAL MEASUREMENTS FROM THE N1/4 OF SECTION 16, AND THE 1/4 CORNER TO SECTIONS 8 & 9, BOTH OF WHICH WERE RE-ESTABLISHED FROM ORIGINAL BEARING TREE EVIDENCE AND FIT ORIGINAL SURVEY MEASUREMENTS VERY CLOSELY. THE POSITION USED FOR THIS CORNER IS BASED ON PRORATION FROM THE S1/4 OF SECTION 7 AND THE N1/4 OF SECTION 16 FOR E-W POSITION. THE DISTANCE FROM THE NE CORNER OF SECTION 8 WAS DOUBLED THROUGH THE E1/4 OF 8 FOR N-S LOCATION. THIS RESULTS IN A BEND IN THE EAST LINE OF SECTION 8 OF LESS THAN 0°03' AND IS WITHIN 5.2' OF THE ORIGINAL N-S MEASUREMENTS IN SECTION 8. THIS SECTION DIMENSIONS CAN BE FOUND ON SUMMARY SHEETS FILED IN

2020 - PLS 2675 FOUND 1-1/2" O.D. IRON PIPE 18"± ABOVE THE GROUND AND 2 WITNESS TREES. NO EVIDENCE OF THE HARRISON SET BY GREEN WAS RECOVERED. THE MONUMENT AGREES WITH BOTH FOUND WITNESS TREES. ACCEPTED THE 1-1/2" O.D. IRON PIPE AS THE CORNER LOCATION. SET 4 NEW TIES AND MEASURED TO THE EXISTING WITNESS TREES.

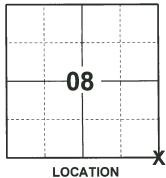

(INDICATE CORNER BY "X")



DATA SHOWN HERE ON THIS TIE SHEET IS CORRECT AND COMPLETE TO THE BEST OF MY KNOWLEDGE AND BELIEF.

PROFESSIONAL LAND SURVEYOR

-TIE SKETCH



VIII TAG ALDER SWAMP M°08 HARDWOODS HOGBACK

- SET 3/4" x 18" IRON REBAR, 1,50#/FT
- FOUND 1-1/2" O.D. IRON PIPE
 - VINYL "T" POST
- WITNESS TREE

U.S. PUBLIC LAND SURVEY MONUMENT RECORD 45 CORNER NO. ADAMS COUNTY 16 SECTION TYPE OF MONUMENT: __nail 18N TOWN STATE PLANE COORDINATES: **7E** RANGE ELEVATION — M.S.L. DATUM: THETA ANGLE: FIELD BOOK: __ DRAWN BY: ____D. Riesop BASIS FOR MONUMENT LOCATION Show info such as: History of corner, with reference to Vol. and pg., dates, surveyor; exact description of monument replaced; if location computed, by taped or EDM traverse; LOCATION landowner remarks, etc. (Use reverse side if necessary) (in conformance with Section A-E 502 of the (Indicated by 'X') SEAL: Wisconsin Administrative Code Area was searched for old post, occupation and brg. trees, nothing was found. I disagreed with the monument set by Green in 1978 because of the large discrepency in original measurements from the N 1/4 of Sec. 16, and the 1/4 corner to Sections 8&9, both of which were reestablished from original bearing tree evidence and fit original survey measurements very closely. The position I used for this corner is based on proration from the S 1/4 of Sec. 7 and the N 1/4 of Sec. 16 for E-W position. The distance from the NE cor. of Sec. 8 was doubled through the E 1/4 of 8 for N-S location. DATA SHOWN HERE ON CERTIFIED CORRECT: This results in a bend in the E. line of Sec. 8 of less than $0^{\circ}03$ 'and is within 5.2' of the original N-S measurements in Sec. 8. Registered Land Surveyor These section dimensions can be found on summary 12/28/83 DATE: ___ sheets filed in June, 1983. TIE SKETCH SCALE 8 1"=40" Show at least four ties, also fence lines, roads, topo. size and type of witness trees' and if off road - hest way to ZOO' WEST arrive at corner. BARN HALL IN DEAD" W. SIDE OF BARN NAIL ILL W. SIDE OF 3! BIŔCH METAL POST HALL DND SIGN"07" MAINTENANCE RECORD Remarks Date Init. BARN NAIL IN W. SIPE 5" B. OAK 11-4-87 1/2" IPG CORNER TRAVERSE 6-10-92 16-85 1-24-02 JG-JS 2-NEW CORNER HOWBACK 10-9-07 56 60 D SPIKE FUD IN 12" POPLE (NOW DEAD) TIE GREEN MONUMENT, POSI ORIG SET BY FROM TIES

LOWREY

•

.


Government Land Corner Certificate

ADAMS	Coun	tv
TYPE OF MONUMENT:	ison Std.	
STATE PLANE COORDINATES:		
	<u>E</u>	
ELEVATION — M.S.L. DATUM	M:	
THETA ANGLE:		
FIELD BOOK:	PAGE	
DRAWN BY:		


BASIS FOR MONUMENT LOCATION

Show info such as: History of corner, with reference to Vol. and pg., dates, surveyor; exact description of monument replaced; if location computed, by taped or EDM traverse; landowner remarks, etc. (Use reverse side if necessary)

Using an E.D.M. traverse beginning at the SE and SW corners of Section 16, set by Kiedrowski, and following the original section measurements, as recorded in Vol. 8, Page 18 and Vol. 3, Page 6 of 1901 and 1925 survey notes we located the West 1 post of Section 17 and set a monument at the base of post. We then calculated the location of and set the NW corner of Section 16.

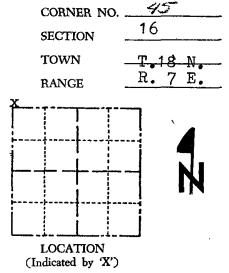

SEAL:

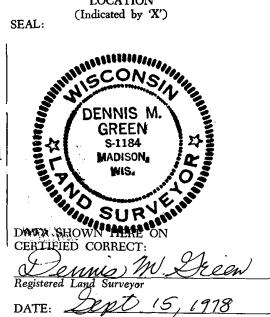

TIE SKETCH

Show at least four ties, also fence lines, roads, topo, size and type of witness trees' and if off road - best way to arrive at corner.

X.

X 11/2"X 24" PIPE 上 \mathbf{Y} SWAMP

¥.

MAINTENANCE RECORD

Date	Init.	Remarks	
	<u> </u>		
	 		
]		

REVISED 1977

HARRISON ST. MONUMENT

*

ADAMS COUNTY Su

irvey Monumei	nt Record_
	HAPPISON

TYPE OF MONUMENT:	HARRISON	MON.
STATE PLANE COORDINATE	S: N	
	<u>E</u>	
ELEVATION — M.S.L. DATUM	[:	
THETA ANGLE:		
FIELD BOOK:	PAGE _	

CORNER NO. . SECTION /8 TOWN 7 **RANGE**

BASIS FOR MONUMENT LOCATION

(Use reverse side if necessary)

Show info such as: History of corner, with reference to Vol. and pg, dates, surveyor; exact description of monument replaced; if location computed, by taped or EDM traverse; landowner remarks, etc.

Ran EDM traverse around Section 16 and tied in all existing evidence.

Set Northwest corner at record distance from East and South.




(Indicated by 'X')

CERTIFIED CORRECT:

DATE:

TIE SKETCH

(Show at least four ties)

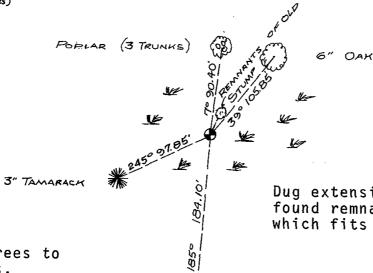

8" OAK

Dug extensive hole and found remnants of old stump which fits original tie.

Ties in Trees to #60 spikes.

Note: