OT ADAMS COUNTY COUNTY CORNER NO: 47

ROMPORTOL ID: 41807090000

PUBLIC LAND SURVEY MONUMENT RECORD

HARRISON TYPE OF MONUMENT: ADAMS COUNTY COORDINATES, NAD 83 (2007) N. **245616.986** E. 572784.359


ELEVATION-___- — — DATUM

01/09/2020 FIELD WORK DATE:


BASIS FOR MONUMENT LOCATION

1983 - PLS 1551 EXCAVATED AREA WITH SHOVEL, NO SIGNS OF STAKE OR BTS FOUND. CORNER RESET BY DOUBLING DISTANCE FROM EAST THROUGH 1/4 CORNER AS FOUND BY INDENTATION OF BT. THIS POSITION ALSO SPLITS THE NORTH LINE OF THE NE1/4 OF 16 ON A STONE FOUND AT THE 40 CORNER. NORTH-SOUTH POSITION USED IS RECORD DISTANCE FROM THE SE CORNER OF 16. THIS CHECKS WITHIN 1' OF DISTANCE MEASURED TO CORNER FROM CENTER OF COTTONVILLE LANE IN 1901 BY SMITH (VOL. 1, PG. 129), AND IS ON A STRAIGHT LINE FROM THE N1/4 OF 16 AS FOUND BY BT STUMPS, THROUGH THE ABOVE MENTIONED STONE. THIS LOCATION WILL ALSO AGREE WITH THE N-S POSITION USED BY DENNIS GREEN IN SETTING 40 CORNERS ALONG THE EAST LINE OF 16.

2020 - PLS 2675 FOUND HARRISON FLUSH WITH THE GROUND AND 3 WITNESS TREES. THE MONUMENT AGREES WITH ALL 3 WITNESS TREES. ACCEPTED THE HARRISON AS THE CORNER LOCATION. SET 4 NEW TIES AND MEASURED TO THE EXISTING WITNESS TREES.

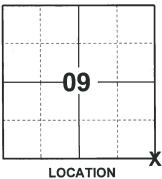

(INDICATE CORNER BY "X")

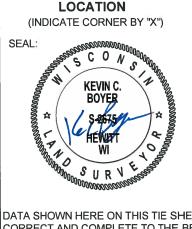

DATA SHOWN HERE ON THIS TIE SHEET IS CORRECT AND COMPLETE TO THE BEST OF MY KNOWLEDGE AND BELIEF.


PROFESSIONAL LAND SURVEYOR

-TIE SKETCH

NOTE: THE CORNER LANDS 11'± WEST OF THE FENCE LINE.



- SET 3/4" x 18" IRON REBAR, 1.50#/FT
- FOUND HARRISON MONUMENT
- STEEL FENCE POST
- VINYL "T" POST
- WITNESS TREE

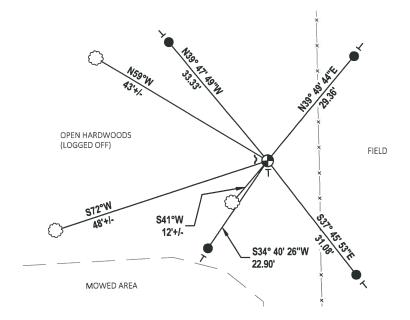

U.S. PUBLIC LAND SURVEY MONUMENT RECORD CORNER NO. 47 *ADAMS COUNTY* 16 SECTION TYPE OF MONUMENT: Standard Harrison 18N TOWN STATE PLANE COORDINATES: RANGE ELEVATION - M.S.L. DATUM: -THETA ANGLE: -FIELD BOOK: Adams County _ PAGE _ 54 DRAWN BY: D. Riesop BASIS FOR MONUMENT LOCATION Show info such as: History of corner, with reference to Vol. and pg., dates, surveyor; exact description of monument replaced; if location computed, by taped or EDM traverse; landowner remarks, etc. (Use reverse side if necessary) (in conformance with Section A-E 502 of the LOCATION SEAL: Wisconsin Administrative Code) Excavated area with shovel, no signs of stake or BTs found. Corner reset by doubling distance from East through 1/4 corner as found by indentation of BT. This position also splits the North line of the NE 1/4 of 16 on a stone found at the 40 corner. North - South position used is record distance from the SE corner of 16. This checks within 1' of distance measured to corner from center of Cottonville Lane in 1901 by Smith (Vol. 1, Page 129), and is on a straight line from the N 1/4 of 16 as found by BT stumps, through DATA SHOWN HERE ON This location will also agree with the N-S position used CERTIFIED CORRECT: the above mentioned stone. by Dennis Green in setting 40 corners along the East Registered Land Surveyor line of Section 16. 6/29/83 12" MAPLE, NAIL TIE SKETCH IN E. SIDE (TOP BROKEN OFF) Show at least four ties, also fence lines, roads, topo, size and type of witness trees' and if off road - best way to arrive at corner. FENCELINE filed for record this day of . CONE 98 per 59.60) 18" WHELOW CHERRY ADAMS COUNTY SURVEYOR SCALE 8 1 - 30 MAINTENANCE RECORD 575°54'W Remarks Date Init. 24" COTTONWOODS OK NAIL IN U. SIDE 3-9-87 6 L 14-35 1-DEAD STILL STANDING I-NEW 1-GONE 3-REMAIN 10" MAPLE ンピ Z-NEW CORNER DIC 56 2-GONE 1-22-02 1-60NE 4-11-07 JG

....